Reserve

Township. N.o 24 N. Range N.o 7 W. Mer. Mich.

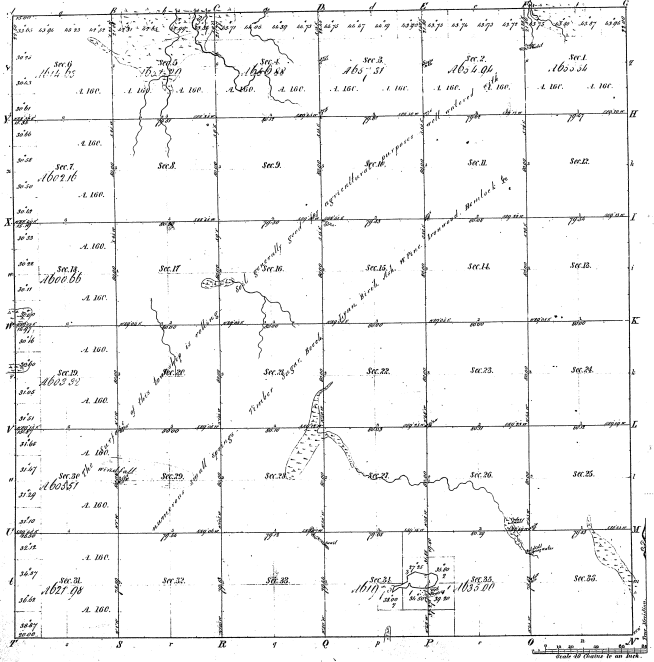

Meanders of Peels Traverse W.ly Peels Traverse W.ly Peels Traverse W.ly

Meanders
1 mile. 66 Chains 2 Links.

15-26

Total number of Acres 22908 77

Surveys Designated	By Whom Surveyed	Date of Contract	Amount of Surveys	When Surveyed	When accepted and by the Surveyor Gen.l
Township lines	Asher Ford	June 16 1836	72 00 00	16th June 1838	
Subdivisions	Thomas Whelpley	April 30 1838	60 06 24	7th Dec.r 1838	

The above Map of Township N.o 24 North of Range N.o 7 West of the Principal Meridian Michigan is strictly conformable to the field notes of the survey thereof on file in this office, which have been examined and approved.

Surveyor Generals Office
Detroit Sept.r 6 1839

Chas. Ashley
Spr. Gen.l