15-25

Re-survey

Township No. 24 N Range No. 8 W - Mer. Mich.

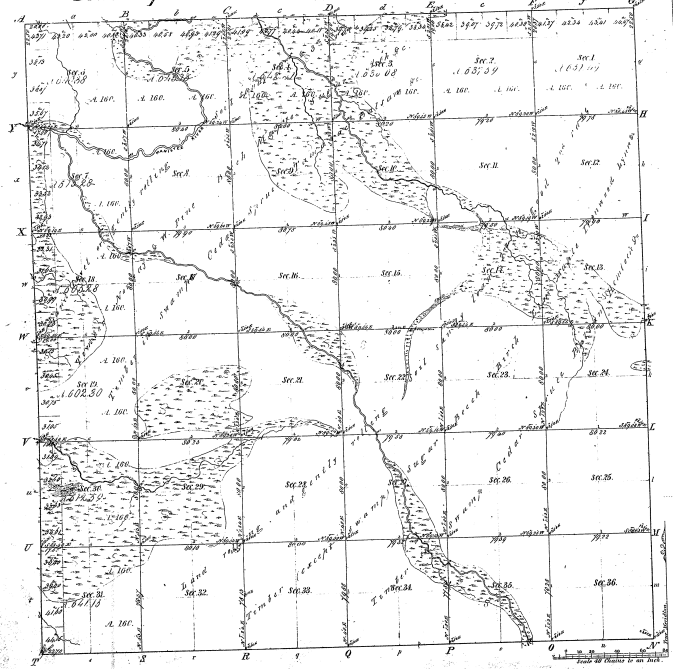

Meanders of							
Posts	Courses	Ch.s	Lks.	Posts	Courses	Ch.s	Lks.

Total number of Acres 2292768

Surveys Designated	By Whom Surveyed	Date of Contract	Amount of Surveys	When Surveyed	When Sur. Gen.l ac'd on the Sur. Gen.l ac'd
Township lines	John Bump	Nov. 16th 1858	M. Ch.s Lks. 72 00 22	4th Quar. 1858	
Subdivisions	Thos. Whelpley	March 21st 1863	59 - 52 - 54	2nd Quar. 1863	

The above Map of Township No. 24 N of Range No. 8 W of the Principal Meridian of Michigan is strictly conformable to the field notes of the survey thereof on file in this Office which have been examined and approved.

Surveyor General's Office
Detroit Feb. 15 1854

Leander Chapman
Sur. Gen.l