Township No. 12 N., Range No. 9 West Mer. (Mich.)

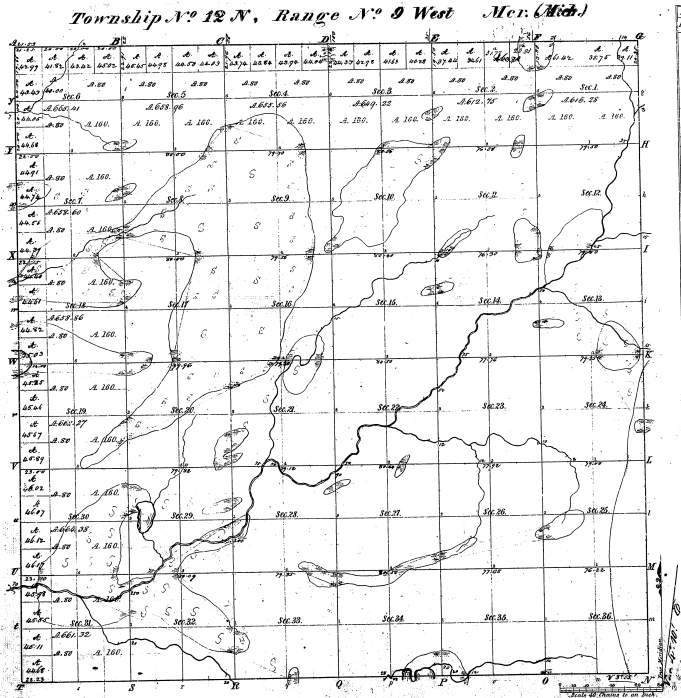

Meanders of

Posts Courses thro'd	Posts Courses thro'd

Total number of Acres 20,160.66

Surveys Designated	By Whom Surveyed	Date of Contract	Amount of Surveys	When Surveyed
Township lines				
Subdivisions	A. C. Van Antwerp	April 22nd 1837	20,160.66	2nd qr 1838 / 3rd qr 1838 / 4th qr 1839

The above Map of Township (12) Twelve North of Range (9) 9 West of the Principal Meridian, Michigan is strictly conformable to the field notes of the survey thereof, returned into the General Land Office, and the same is approved.

Surveyor General's Office, Detroit, April 22nd 1839

C. S. Lewis, Surv. Gen.

11-36