


Township N. 10 N., Range N. 13 West Mer. (Mid.)

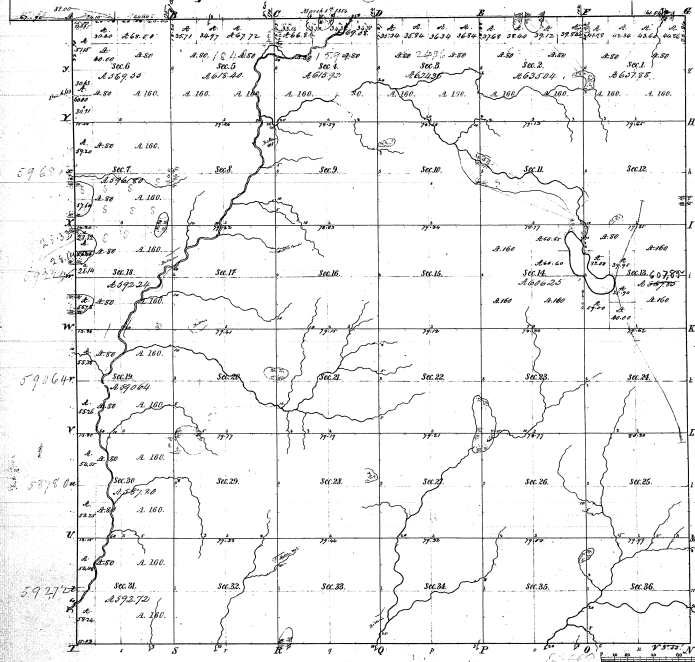

Members of a Lake in Section 10 1/4


Total number of acres 5927.44

Survey designated	By Whom Surveyed	Date of Contract	Amount of Survey	When Surveyed	How far and when the Survey was made
Township Area	N. K. Reynolds	Oct. 31, 1856	5927.44	5-1857	1857
Subdivisions	H. M. Smith	June 22, 1857	41.25	21-1857	1857


 C. J. [Signature]

151  
 8-4