Township No. 41 N. Range No. 12 West Mer: (Mich.)

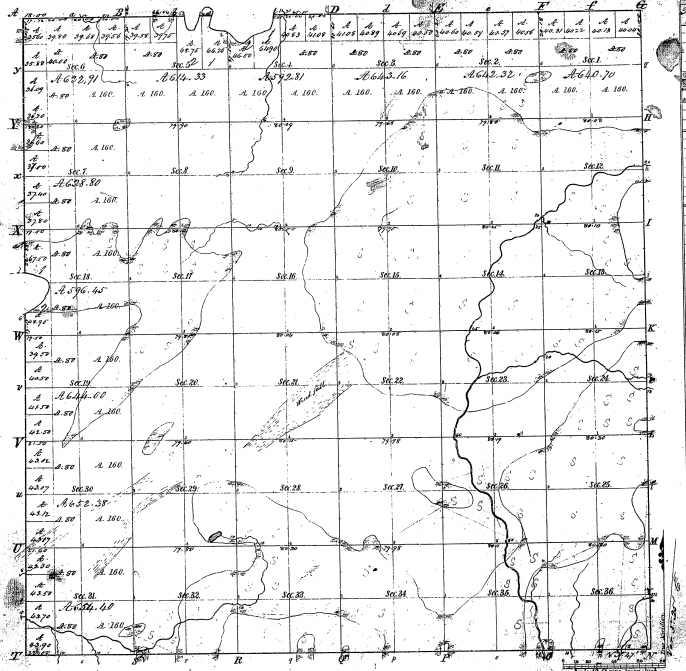

Scale 40 Chains to an Inch.

Total number of Acres 22,232.26

Surveys Designated	By Whom Surveyed	Date of Contract	Amount of Surveys	When Surveyed	When Offices and Mss. Rec'd Gen'l Office
No 1 Township lines	A. Churchill &c.	31st Oct. 1826	96 93 00	1826	3rd Jan. 1838
Subdivisions	A. R. Mellish	July 31. 1827	61 65 24	1826 1827	3rd Jan. 1838
No 2 Township lines	Chas. Hodgdon	Nov 19. 1827	11 71 . 60	1827	3rd Jan. 1838

The above Map of Township No 41 North of Ranges No 12 West of the Principal Meridian Michigan is strictly conformable to the field notes of the survey thereof now in this Office, which have been examined and approved.

Surveyor General's Office Detroit Mich. 4th Jan. 1838

Surv. Gen'l