Re-survey

# Township No. 21 N. Range No. 2 East. Mer. Mich.

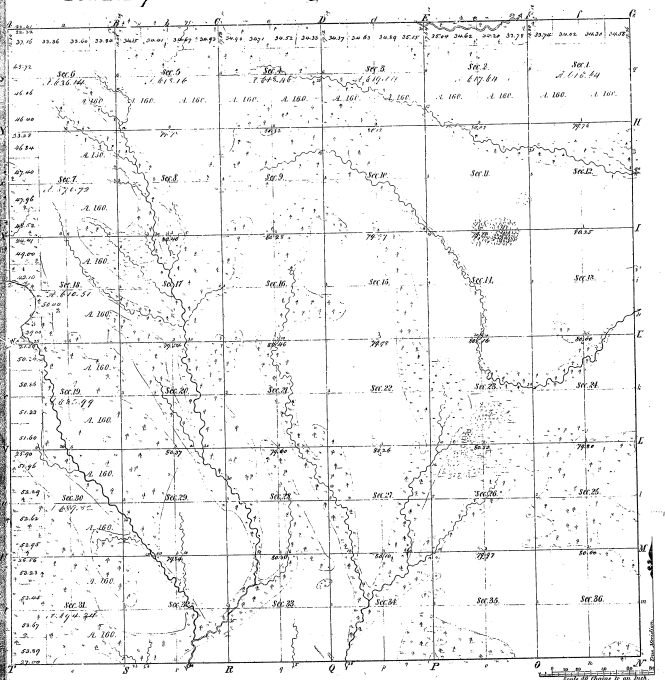


| Meanders of | | | | | | | | |
|---|---|---|---|---|---|---|---|---|
| Posts | Courses | Ch. Lk. | Posts | Courses | Ch. Lk. | Posts | Courses | Ch. Lk. |
| | | | | | | | | |

21-34

21-39

Total number of Acres 25075.35

| Surveys Designated | By Whom Surveyed | Date of Contract | Amount of Surveys | When Surveyed | When gr. Cor. and chd. in the Surv. Gen. Ls. Ass. |
|---|---|---|---|---|---|
| | | | M. Ch. Lk. | | |
| Township lines | Lewis Glasen | July 10. 1837 | | 1st gr. 1832 | |
| Subdivisions | B. F. Hall | Jan. 14. 1846 | 60.79.24 | 2nd gr. 1846 | |

The above Map of Township No. 21 North of Range No. 2 East of the Principal Meridian Michigan, is strictly conformable to the field notes of the survey thereof on file in this Office, which have been examined and approved.

Surveyor General's Office.
Detroit, July 28. 1846

Lucius Lyon, Supr. Gen.