Re-survey

Township No. 24 N. Range No. 1 E. Mer. Mich.

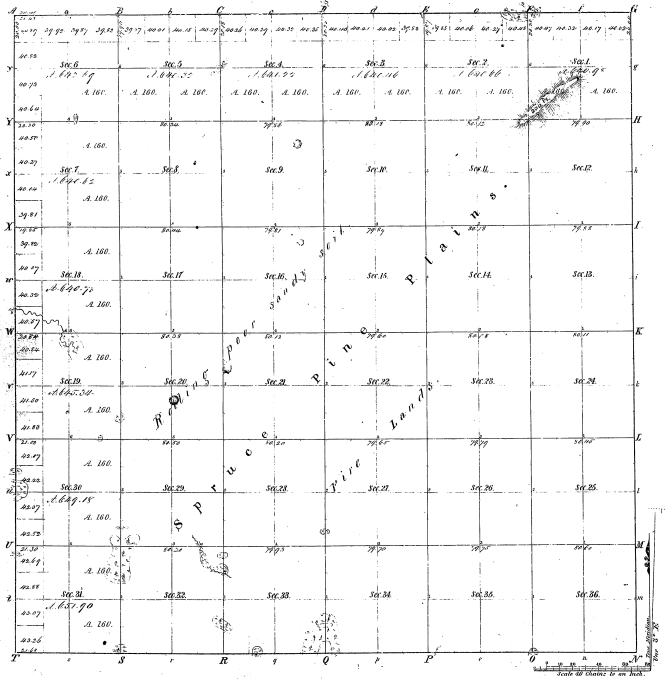

Meanders of							
Posts	Courses	Ch.s lk.s	Posts	Courses	Ch.s lk.s	Posts	Courses	Ch.s lk.s

21-25

21-25

Total number of Acres 23074.15

Surveys Designated	By Whom Surveyed	Date of Contract	Amount of Surveys	When Surveyed	When pr. the ord. ch.s in the Surv. Gen.l wo.s
Township lines	Lewis Olesen	July 10. 1837	M. Ch.s Lks.	1st q.r 1838	
Subdivisions	Jos. H. Mullett	July 14. 1846	20. 03. 39	2d q.r 1846	

The above Map of Township No. 24 North, of Range No. 1 East of the Principal Meridian Michigan, is strictly conformable to the field notes of the survey thereof on file in this Office which have been examined and approved.

Surveyor General's Office,
Detroit Aug.t 4th 1846.

Lucius Lyon
Sur. Gen.l