Township. No 47 N. Range. No 38 W. Mer. Mich.

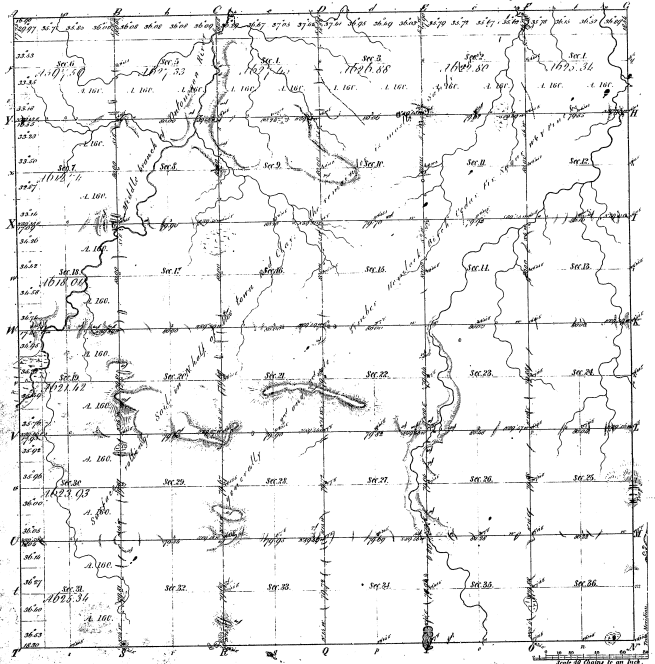

Meanders of
Trails Traverse N°41 E° Trails Courses N°41 E°

43-15

Total Number of Acres 29828.82

Surveys Designated.	By Whom Surveyed & Date of Contract	Amount of Surv.	When Surveyed
Township.	47th & Indian Boundary April 27 1847	23 74	3rd Quarr. 1847
Subdivision	Zelotes R. Searle April 16 1851	69. 62. 78	2nd Quarr. 1851

When 2nd Cor and Cl's on the 3rd Cor'l's not

The above Plan of Township No 47 North of Range No 38 West of the Principal Meridian Peninsula is strictly conformable to the field notes of the survey thereof on file in this Office which have been examined and approved.

Surveyor Generals Office
Detroit July 16. 1852

Charles Noble
Surv. Gen.