Township. N.o 48 N. Range. N.o 40 W. Mer. Mich.

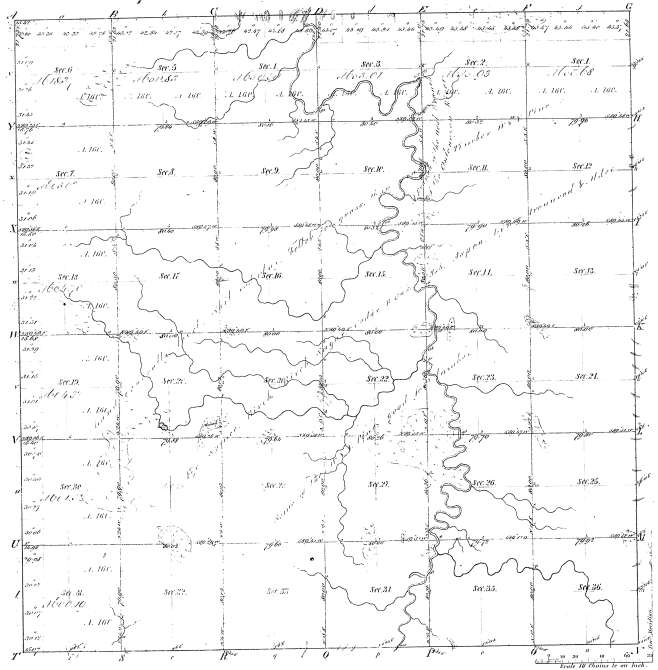

Meanders of
Poste Courses 1851 Poste Courses 1851 Poste Courses 1851

43-10

43-10

Total number of Acres 23,040.00

Surveys Designated	By Whom Surveyed	Date of contract	Amount of Surveys	When Surveyed	When Plat and Notes in the Surveyor Gen.l's office
Township lines Subdivisions	John Hurd Wells Hurd	April 27 1847 April 29 1851	M. 78. 45. 59. 65. 97	3rd Quar. 1847 3rd Quar. 1851	

The above Township, No. 48 North of Range No. 40 West of the Principal Meridian Michigan is strictly in accordance with the field notes of the survey thereof on file in this Office, which have been examined and approved.

Surveyor Generals Office
Detroit Dec. 5. 1851

Charles Noble
Surv.r Gen.l