42-2

Township No. 50 N. Range No. 45 W. Mer. Mich.

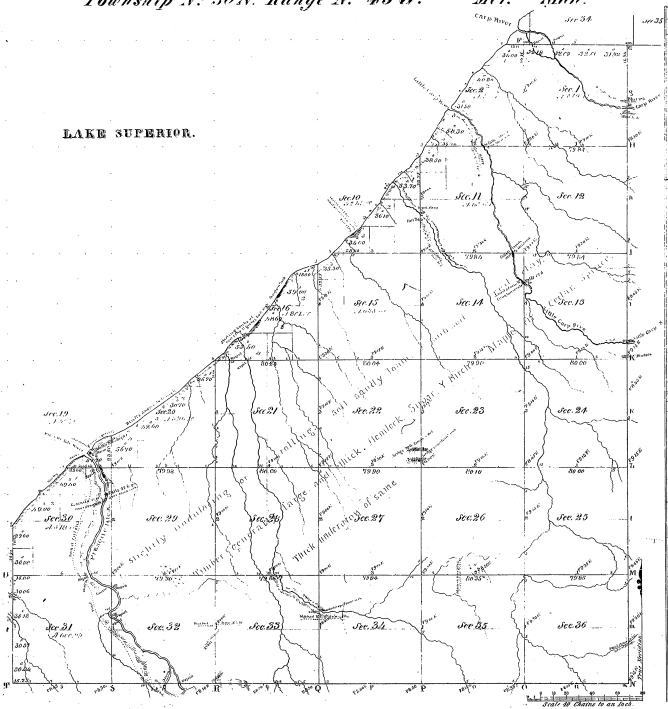

Meanders of								
Sec. 35	Path	Courses	Ch.s Lk.s	Path	Courses	Ch.s Lk.s	Path	Courses	Ch.s Lk.s

Total meanders 6 m. 40 ch. 10 lks.

Total number of Acres 13236.28

Surveys Designated.	Re When Surveyed.	Date of Contract.	Amount of Surveys M. Ch.s Lk.s	When Surveyed.	When Changed in the Surv. Genl's Acct.
Township lines.	Wm. A. Burt Jr. Austin Burt	April 27 1847	11 . 71 . 19	Sept. 1847	
Subdivisions.	Austin Burt	Bond Dec. 1st 1848	67 . 65 . 83	Sept. 1848	

The above Map of Township No. 50 North of Range No. 45 West of the Principal Meridian, Michigan is strictly conformable to the field notes of the survey thereof on file in this Office, which have been examined and approved.

Surveyor General's Office
Detroit March 5th 1849

Lucius Lyon, Surv. Genl.