


TOWNSHIP NO.26 NORTH, RANGE NO.1 EAST, OF THE MICHIGAN MERIDIAN, MICHIGAN.

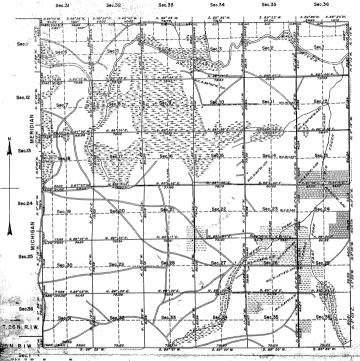

MEMORANDUM


THE RESURVEY WAS EXECUTED PURSUANT TO AUTHORITY CONTAINED IN GENERAL LAND OFFICE LETTER 167640. "E" OATED MARCH 23, 1937, AND LETTER DATED MAY 16, 1937, WHICH BEARS DEPARTMENTAL APPROVAL UNDER THE SAME DATE.

WITH THE EXCEPTION OF SWALL CLEARED AREAS, THE TOWNSHIP SUPPORTS A SCATTCHING TO FAIR STAND OF JACK PINE, BLACK OAK, AND POPLAR TIMBER ON THE UPLAND, WITH SWALL CEDAR, SPRUCE, AND TAWARACK IN THE SWAUNS

SOLE: 10 CHAINS TO AN INCH. AREA RESUBVEYED: 23,027.79 ACRES.

GROUP MILEAGE WHEN SURVEYED LINES DESIGNATED BY WHOM SURVEYED DATE MLS. CHS. BEGUN COMPLETED EXTERIOR ENGINEER. 12 5.00 APRIL 12, WAY 13, AUGUST 4, JAMES T. BOYD AND SUBDIVISIONAL 1937. 1937. 1937. T. NOLAN CANADA, 59 71.24 TRANSITHEN

OFFICE OF THE SUPERVISOR OF SURVEYS.
DENVER, COLORADO, CULY 24, 1940.

THE ABOVE PLAT OF TOWNSHIP NO. 26 NORTH, RANGE NO. 1 EAST, MICHIGAN MERIDIAN, MICHIGAN, IS STRICTLY CONFORMABLE TO THE FILE NOTES OF THE RESURVEY THEREOF, WHICH HAVE BEEN CXABINED AND APPROVED.

SUPERVISION OF SURVEYS.

UNITED STATES
DEPARTMENT OF THE INTERIOR.
GENERAL LAND OFFICE.

MASHINGTON, D. C., APRIL 7, 1941.

THE RESURVEY REPRESENTED BY THIS PLAT, HAVING BEEN
OF LAW AND THE REQUIRATIONS OF THIS OFFICE, IS HEREBY
OF LAW AND THE REQUIRATIONS OF THIS OFFICE, IS HEREBY

Del David Wolfsohn.