


Township 1<sup>o</sup> 27' N. Range 1<sup>o</sup> E. Mer. Mich.

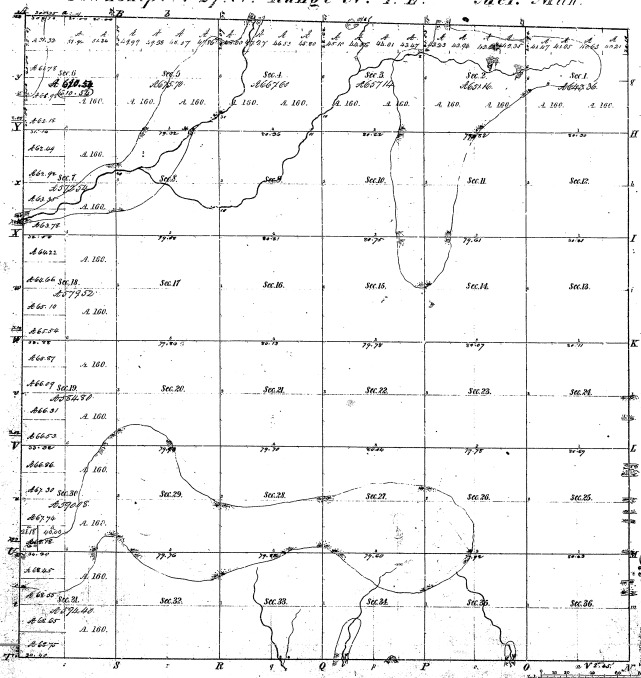




