


Township 1° 28' N. Range 1° E. Mer. Mich.

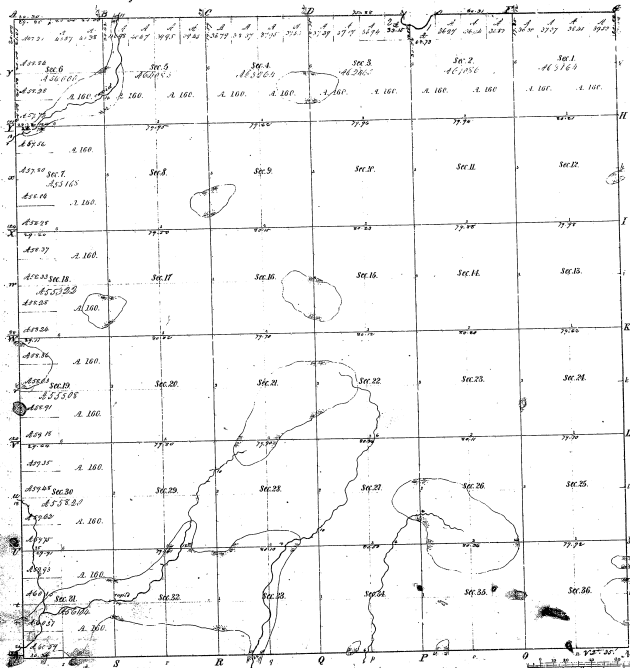






The above map of Township 1° 28' North of Range 1° East of the Principal Meridian Michigan is strictly conformable to the field notes of the survey thereon on file in the Office and have been examined and approved.

George Towns Office
Grand Rapids Mich. 25th 1839

G. Towns