18-37

Township No. 31 N. Range No. 2 W. Mer. Mich.

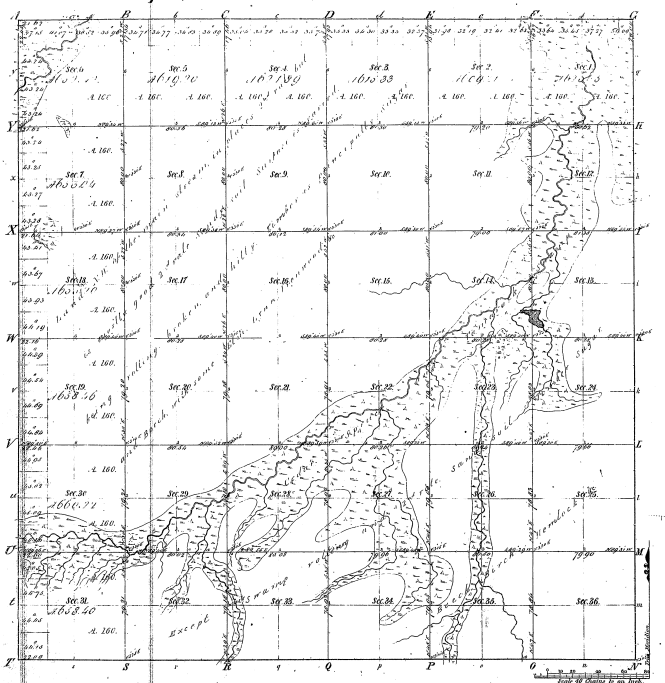

Meanders of							
Posts	Courses	Ch.s Lk.s	Posts	Courses	Ch.s Lk.s	Posts	Courses	Ch.s Lk.s

Total number of Acres 23028.52

Surveys Designated	By Whom Surveyed	Date of Contract	Amount of Surveys	When Surveyed	When Sec. 6th and 7th in the Surv. Gen.l am.t
S. Bdy. to Township 1st Mer.	J. Wolfgang & S. Wyer Wm. Wolfe	Jan. 26. 1839 Jan. 12. 1840	M. Ch.s Lks. 5 67	2nd Quar. 1839 1st Quar. 1842	
Subdivisions	Austin Bust	April 19. 1850	59 67	2nd Quar. 1850	

This above Map of Township No. 31 North of Range No. 2 West of the Principal Meridian Michigan is strictly conformable to the field notes of the survey thereof on file in this Office, which have been examined and approved.

Surveyor General's Office
Detroit, Dec. 23 1850

Charles Noble Surv. Gen.l