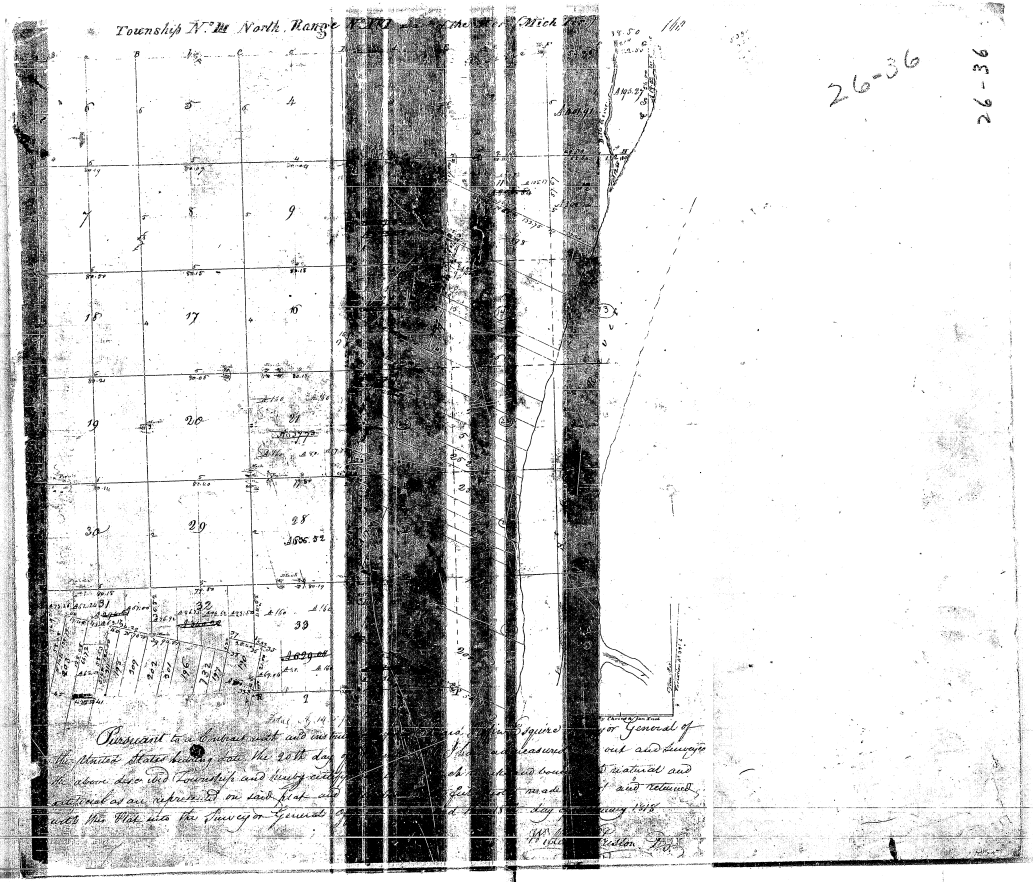

26-36
26-36