


Township N. VI south, Range N. II West 3<sup>rd</sup> Mer. Min. Ter.

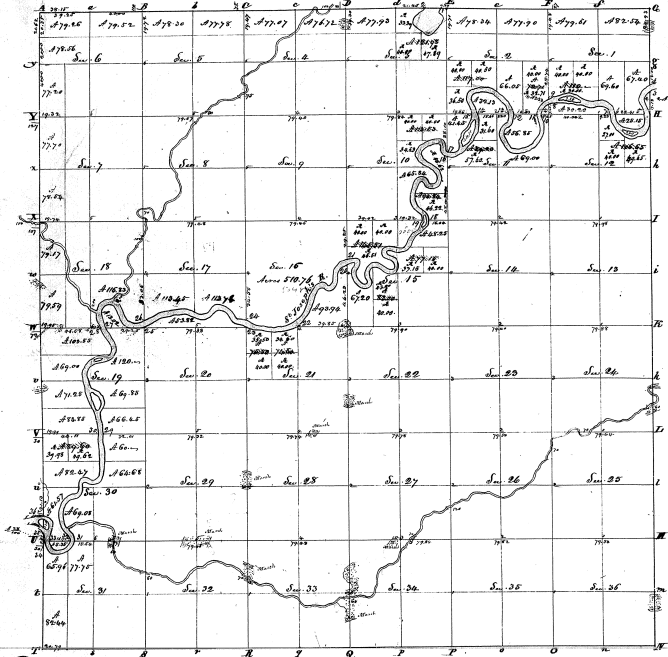

224


