Township N.º 13 N Range N.º 14 E Mer. Mich.

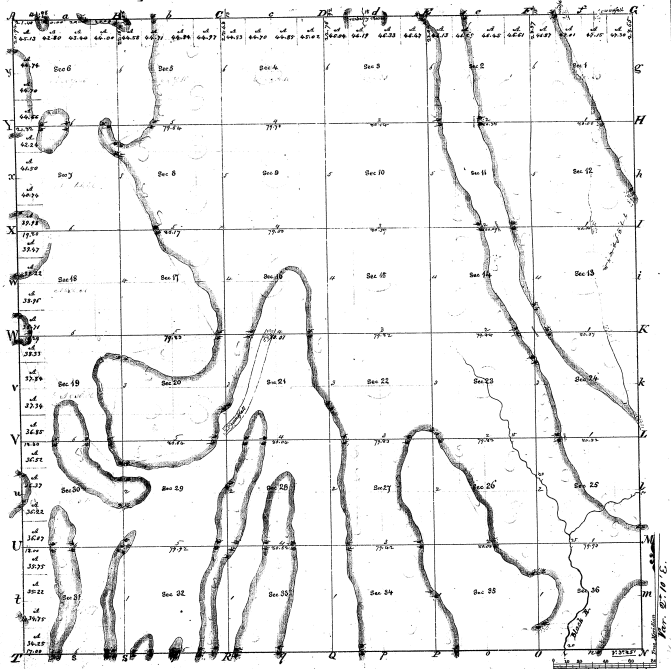

Meanders of

South Courses	Dist.s	West Courses	Dist.s	East Courses	Dist.s

133

25.26

25.26

Dots: number of Acres

Surveys Designated	By Whom Surveyed	Date of Contract	Amount of Surveys	When Surveyed	When approved by the Surveyor General	When filed in the Gen.l Land Office
Subdivision.	Josiah Conn	11. Aug. 1834	10. 47	4th of 1834	1st of 1835	
Township lines.	Harvey Parks	29th Nov. 1833	24. 03. 51	1834	2 of 1834	

The above Map of Township N.º 13 North, of Range N.º 14 East of the Principal Meridian, Mich. Ter.y is strictly conformable to the field notes of the survey thereof on file in this Office, which have been examined and approved

Surveyor Generals Office, Tiscilanti Mich. 30 1835

M. T. Williams
Surv.r Gen.l