Township No. 13 N. Range No. 15 E. Mer. Mich.

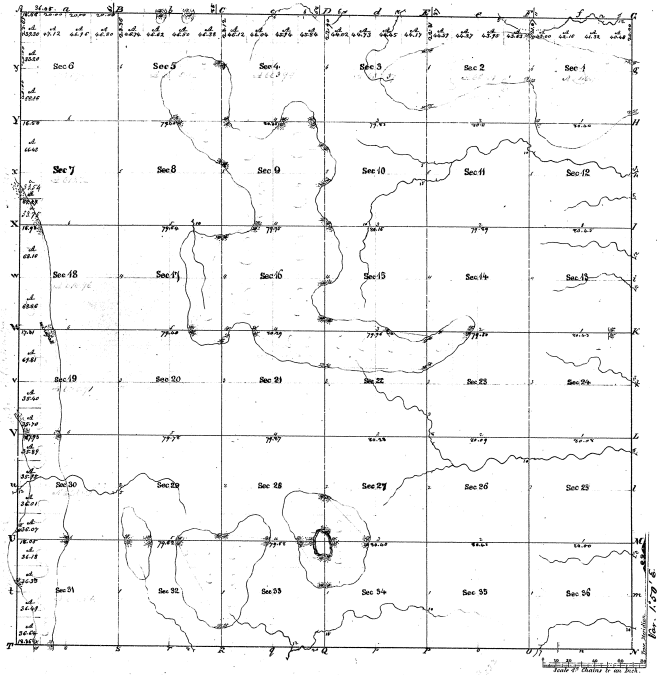

Meanders of

Poste	Courses	(E of N)	Poste	Courses	(E of N)	Poste	Courses	(E of N)

25-27

25-27

Surveys Designated.	By Whom Surveyed.	Date of Contract	Amount of Surveys			When Surveyed	When Plat was sent to the Surr. Gen.l Off.e
			M.	M.	Lks.		
Subdivision.	Josiah Enos	Aug. 11. 1834.	62.	00	08	4th Qr. 1834.	1st Qr. 1835
Township lines.	Harvey Parks	25th Aug. 1835	25.	78.	66	1834	2nd Qr. 1836

Total number of Acres 23,041.10

Scale of Chains to an Inch.

The above Map of Township No. 13 North, of Range No. 15 East of the Principal Meridian, Mic. Ter. is strictly conformable to the field notes of the surveys thereof on file in this Office, which have been examined and approved.

Surveyor Generals Office,

M. T. Williams
Surr. Genl.