Township N. V North, Range N. I East Mer. (Mic. Ter.)

29-24

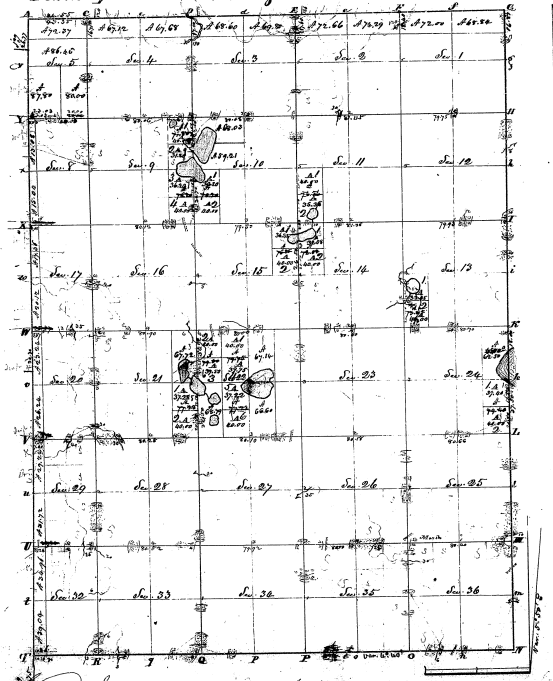

Surveyed in March 1824 by Joseph Manypenny Dep.

Contents			Contents		
Fractional	Acres	Wits	Fractional	Acres	Wits
N½ NE 1	63	84	Sec. 16	640	
S½ "	80		E½ 17	320	
N½ NW "	78		NW "	17	76
S½ "	80		SW "	20	12
S½	320		E½ 20	320	
N½ NE 2	74	29	NW "	20	24
S½ "	80		SW "	24	24
N½ NW "	78	66	W½ 21	320	
S½ "	80		E½ NE "	67	72
S½	320		W½ "	80	
N½ NE 3	69	80	E½ SE "	77	28
S½ "	80		W½ "	80	
N½ NW "	66	60	E½ NE 22	80	
S½ "	80		W½ "	67	14
S½	320		E½ NW "	79	76
N½ NE 4	67	68	W½ "	79	80
S½ "	80		E½ SE "	80	
N½ NW "	67	12	W½ "	80	60
S½ "	80		E½ SW "	77	22
S½	320		W½ "	65	79
N½ NE 5	78	07	Sec. 23	640	
S½ "	86	46	W½ 24	320	
E½ SE "	80		E½ NE "	80	80
W½ "	87	80	W½ "	80	
E½ 8	320		E½ SE "	79	40
NW "	130	08	W½ "	80	
SW "	150	04	Sec. 25	640	
W½ 9	320		26	640	
E½ NE "	71	80	27	640	
W½ "	80		28	640	
E½ SE "	76	20	E½ 29	320	
W½ "	80		NW "	29	64
E½ 10	320		SW "	31	72
W½ NW "	68	00	E½ 32	322	
S½ "	87	24	NW "	36	96
E½ SW "	80		SW "	39	24
W½ "	70	80	Sec. 33	640	
E½ 11	320		34	640	
NW "	160		35	640	
W½ "	76	36	36	640	
Sec. 12	640			6845	52
E½ 13	320			7515	12
NW "	160		Total Acres	17,060	64
E½ SW "	80				
W½ "	73	65			
E½ 14	320				
SW "	160				
E½ NW "	80				
W½ "	78	28			
W½ 15	320				
SE "	160				
E½ NE "	76	85			
W½ "	80				
	7515	12			