Township No. 12 N, Range No. 10 E, Mer. Mich.

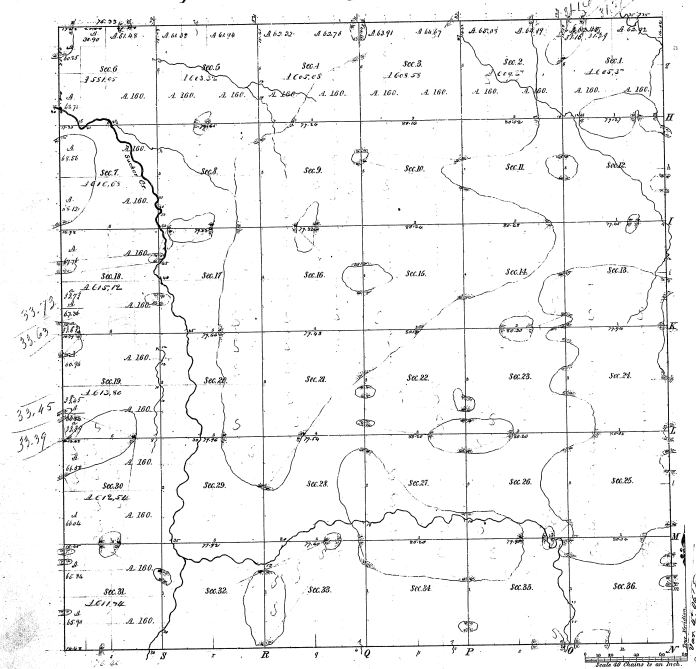

Meanders of					
Posts	Courses	Ch. Lks.	Posts	Courses	&c.

24-33

Total number of Acres 22,633,45

Surveys Designated	By Whom Surveyed	Date of Contract	Amount of Surveys	When Surveyed	When 1st or 2nd ch. in the Sur. Con. to cost
Township lines	Alexander Parker	20th Nov. 1830	M. Ch. Lks. 24 64 33	4th of 1834	3rd of 1835
Subdivisions	Same	11th Aug. 1834	54 42 88	1st of 1835	2nd of 1836

The above Map of Township No. 12 N. of Range No. 10 E. of the Principal Meridian Michigan is strictly conformable to the field notes of the survey thereof on file in this Office, which have been examined and approved.

Surveyor General's Office.
Cincinnati.

Sur. Genl.

62