Township No. 13 N. Range No. 10 E., Mer. Mich.

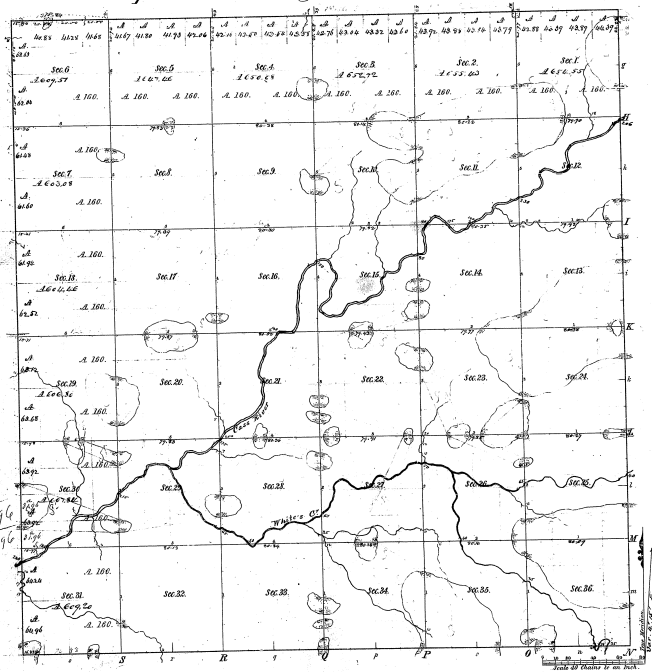

Meanders of							
Posts	Courses	Dist.	Posts	Courses	Dist.	Posts	Courses	Dist.

Total number of Acres. 22,901.13

Surveys Designated	By Whom Surveyed	Date of Contract	Amount of Surveys	When Surveyed	Plotting Fee and Dist. due thereon	
Township lines	Heaverly Parker	22nd Nov. 1832	23. 70. 29	1st qr. 1834	3rd qr. 1835	
Subdivisions	James	11th Sep. 1830	17. 62. 86	1st qr. 1835	2nd qr. 1836	

The above Map of Township No. 13 N. of Ranges No. 10 E. of the Principal Meridian Michigan is strictly conformable to the field notes of the surveys thereof on file in this Office, which have been examined and approved.

Surveyor Generals Office, Cincinnati.

Surv. Gen.l