


Township N^o 1 S. Range N^o 7 E. (Mich.) Mer. - [Resurvey]

55

31-4

21-4

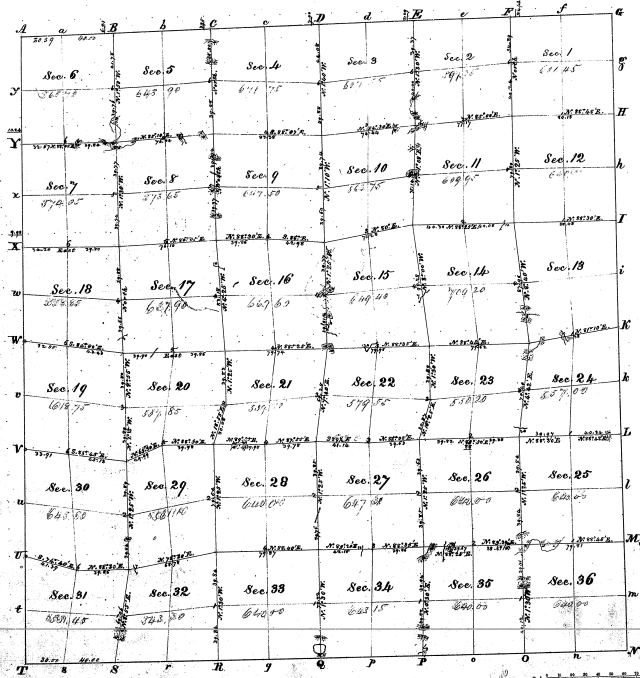

Resurveyed in 1844 by Henry Parke, Deputy Surveyor.

I certify that the above is a true and correct copy of the line and
 original plat on file in the office of the U.S. & T. Surveyor.
 Surveyor General's Office, William Hamilton, Secy. Genl.
 Detroit, Mich., 1855.



54

Subdivided as ahd, with contents as returned

31-4

31-4

142	143	144	
-----	-----	------

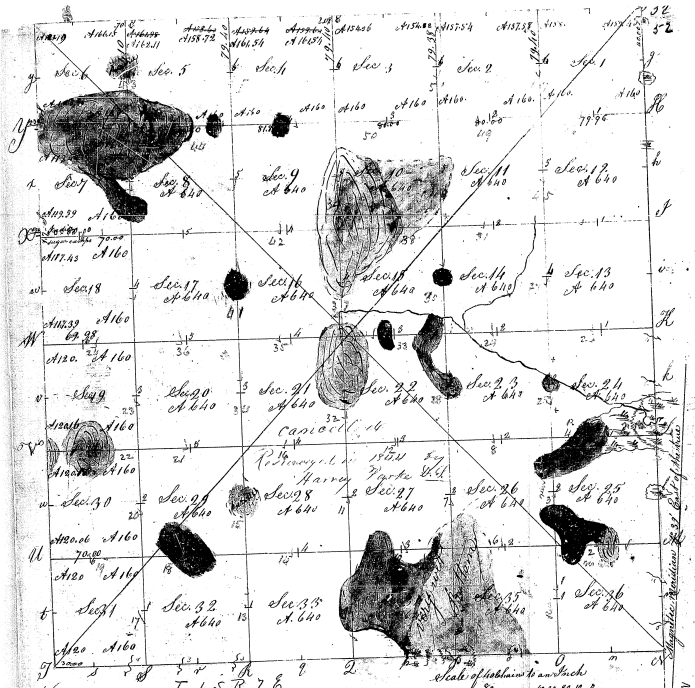

Pursuant to a contract with, and Instructions from
 Edward Kiffin Esq. Surveyor General of the United
 States, bearing date the 26th day of August 1845. I have administered
 laid out and surveyed the above described Township; and do hereby certify
 that it contains such Marks and Bounds both natural and artificial as
 are represented on said Plat, and described in the Field notes made thereof
 and returned with the Plat and the Surveyor General's office.
 Certified this 11th day of March 1846. *Wm. H. ...*

T 15 R 7 E

314