Township No. III South, Range No. III East of Mer. (Third Div.) 20

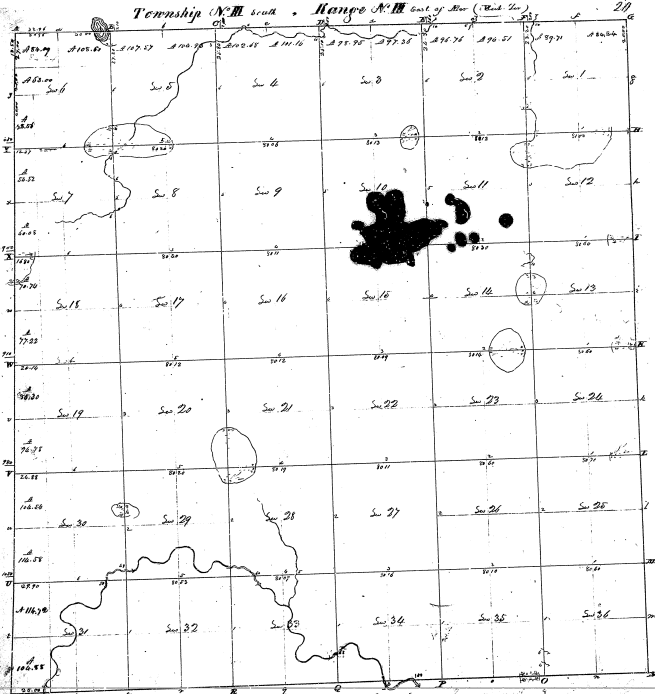

Total C. H. 23,283.46

Pursuant to a contract with and instructions from Edward Tiffin Surveyor General of the United States, bearing date the day of

I have admeasured and run out and designed the above township, and do certify that it has such marks and boundaries, both natural and artificial, as are represented on said plat, and described in the field notes made thereof and returned with this plat into the Surveyor General's Office. Certified this day of 1824.

John M. Mason