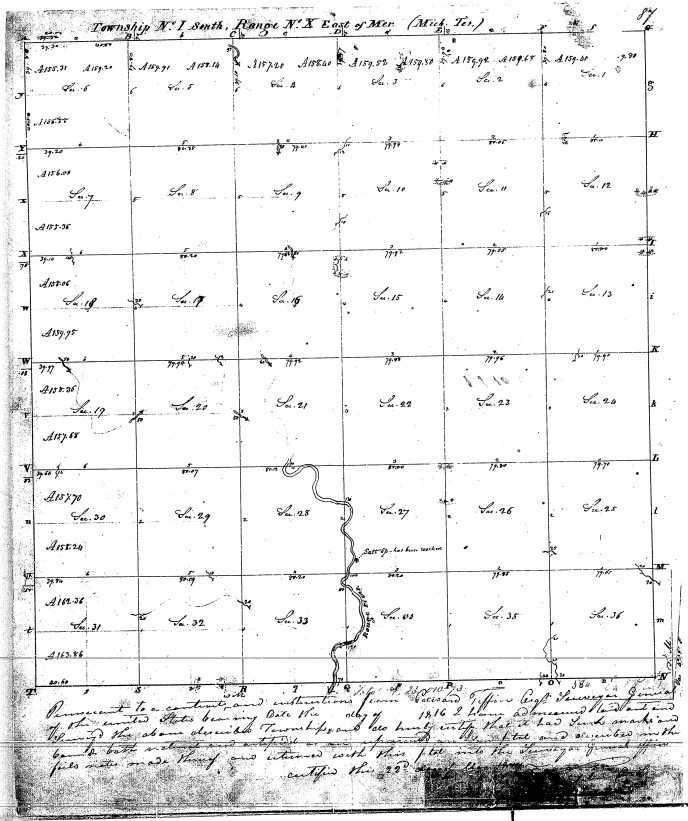
Township N.° 1 South, Range N.° X East of Mer. (Mich. Ter.)
87

31-1

31-1

36