Township N.o 23 N., Range N.o 11 West Mer. (Mich.)

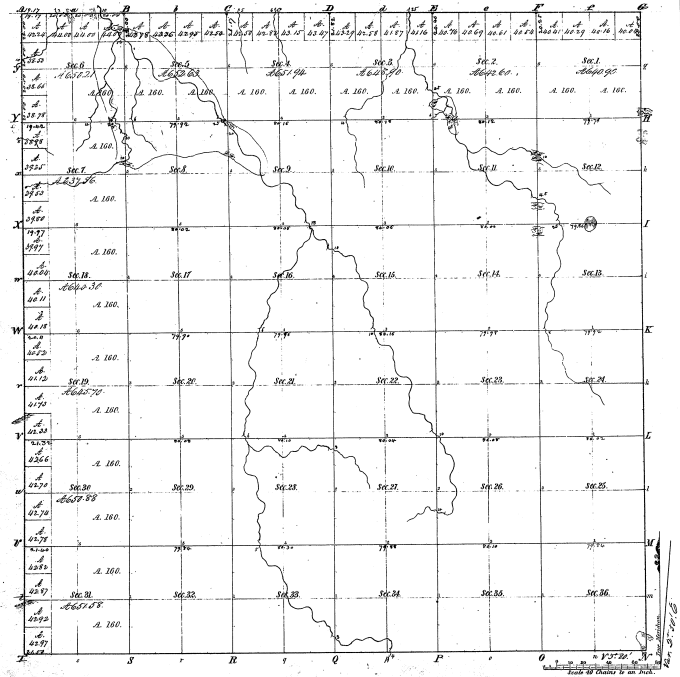

Meanders of

Posts	Courses	Ch. Lks.	Posts	Courses	Ch. Lks.	Posts	Courses	Ch. Lks.

16-31

16-31

Total number of Acres 23 113 20

Survey Designated	By Whom Surveyed	Date of Contract	Amount of Surveys	When Surveyed	Whether the said Contract has been complied with
Township Lines	John Brooks	Nov. 8th 1826	N. 23 W. 45	3rd Dec. 1831	3rd Dec. 1831
Subdivisions	James	1829	66 67 66	4th Dec. 1839	4th Dec. 1839

The above Map of Township N.o 23 North of Range N.o 11 West of the Principal Meridian Michigan is strictly conformable to the field notes of the survey thereof on file in this Office, which have been examined and approved.

Surveyor Generals Office
Cincinnati June 1st 1840

C. S. Sibley Surv. Gen.l