N.T. Mich 24-11 W
Mich

Township. N.o 24 N., Range N.o 11 West Mer. (Mich.)

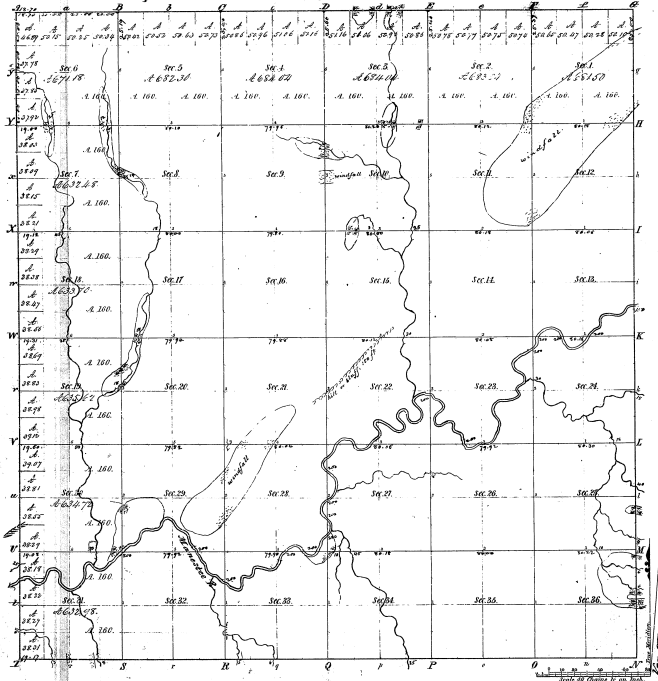

Meanders of			
Pralle Courses	West Courses	Pralle Courses	West Courses

16-26

16-26

Total number of Acres 23,355.60

Surveys Represented	By Whom Surveyed	Date of Contract	Amount of Surveys	When Surveyed	When plat for and abt to be Surr Gen.l sent
Township Lines	Andrew Schindler	Nov. 4th 1836	24	2nd qr 1837	3rd qr 1838
Subdivisions	Same	" 1839	66.23.47	4th qr 1838	1st qr 1839

The above Map of Township 24 N. North of Range 11 W. of the Principal Meridian in Michigan is strictly conformable to the field notes of the survey thereof on file in this Office, which have been examined and approved.

Surveyor Generals Office
Cincinnati, Sept. 18th 1840

E. S. Sibley Surr Genl