Resurvey

Township No. 35 N. Range No. 3 E. Mer. Mich.

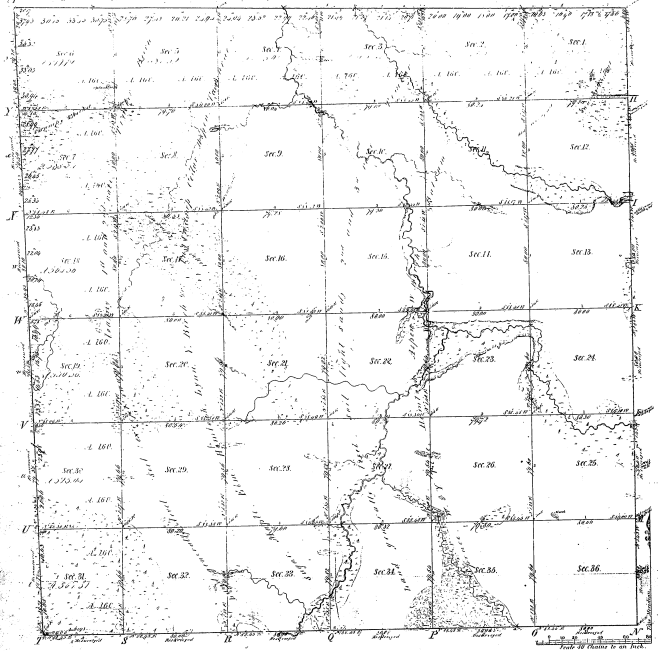

Meanders of
Posts Centres 18 Lks Posts Centres 18 Lks Posts Centres 18 Lks

19-39

19-39

Total number of Acres 22,153.18

Surveys Designated	By Whom Surveyed	Date of Contract	Amount of Surveys	When Surveyed	When Ft. Ins. and Ch.s on the Inv. Gen.l Sec.s
			W. Ch. Ins.		
Subdivisions	Geo. H. Cannon	Oct. 8th 1854	58. 57. 87	3rd Quar. 1855	

The above Map of Township No. 35 North of Range No. 3 East of the Principal Meridian of Michigan is strictly conformable to the field notes of the survey thereof on file in this Office which have been examined and approved.

Surveyor General's Office
Detroit, Michigan 13th 1856

Seander Chapman
Sur. Gen.l

Cam.d Copy made