Resurvey

Township N.o 35 N. Range N.o 5 E. Mer. Mich.

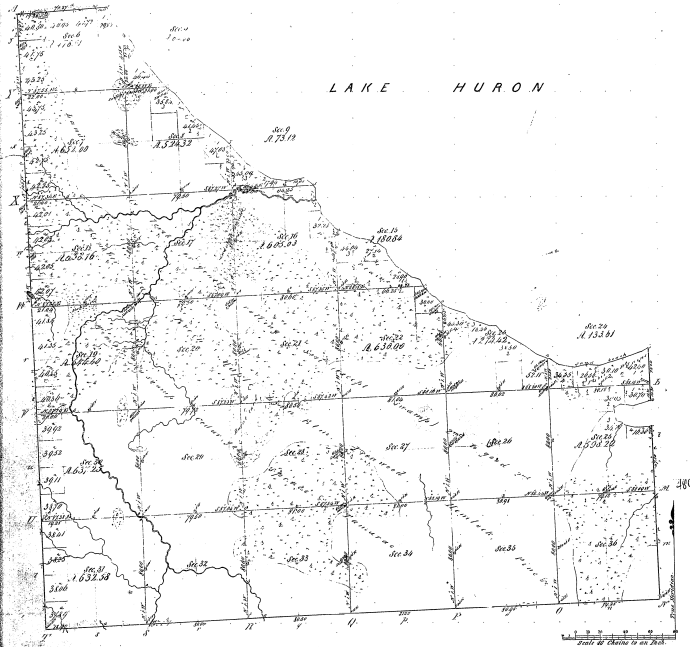
LAKE HURON
A 652.24
