Resurvey

Township No. 36 N. Range No. 2 E. Mer. Mich.

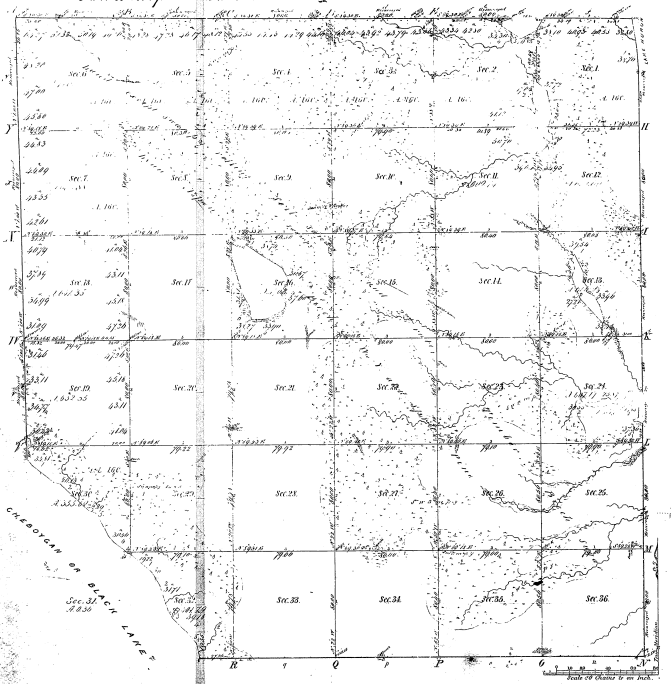

Meanders of
Pods Centres 40 Rds Pods Centres 40 Rds Pods Centres 40 Rds

19-33

Surveys Designated	By Whom Surveyed	Date of Contract	Amount of Surveys	When Surveyed	Range & Sec. and Sec. to the Ins. Gen. Off.
Township lines & Ex.	John Hodgson	June 4th 1849	21 87 56	2nd Quar. 1849	
Subdivisions	Geo. H. Cannon	Oct 2nd 1854	08 50 05	2 Quar. 1854	
	H.B. Geo. H. Cannon	Oct 2nd 1854	5 41 50	2nd Quar. 1854	

Total number of Acres 21650/100

The above Map of Township No. 36 North of Range No. 2 East of the Principal Meridian of Michigan is strictly conformable to the field notes of the survey thereof, on file in the Office which have been examined and approved.

Surveyor General's Office
Detroit April 23 1856

Surveyor General

Cert. Copy made