


5-9-p


R-9
U. S. Department of Agriculture
Forest Service
LAKE AND STREAM SURVEY
PETE'S LAKE
Hiawatha National Forest
Michigan

Location Sec's 7 & 8 T.44N. R.18W.
Scale 1" = 660'


Area 185 Acres
Length of Shore Line 3.5 Miles

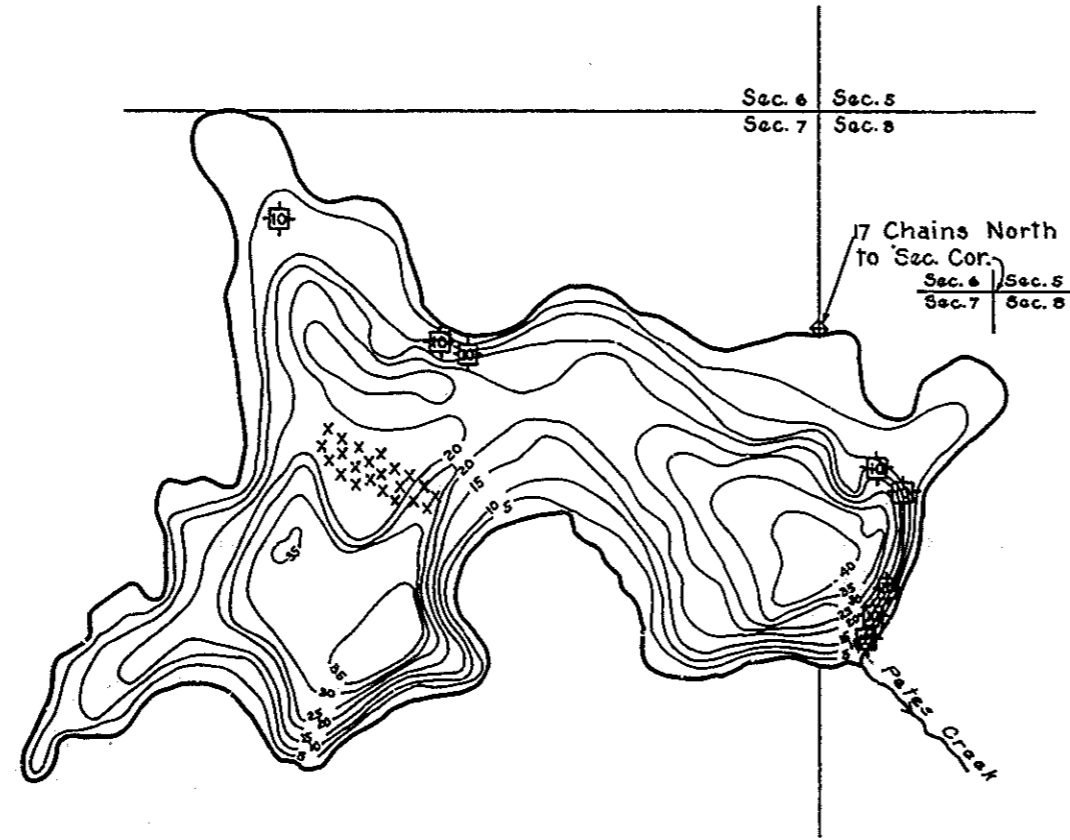

Contour Map
Contour Interval - 5'

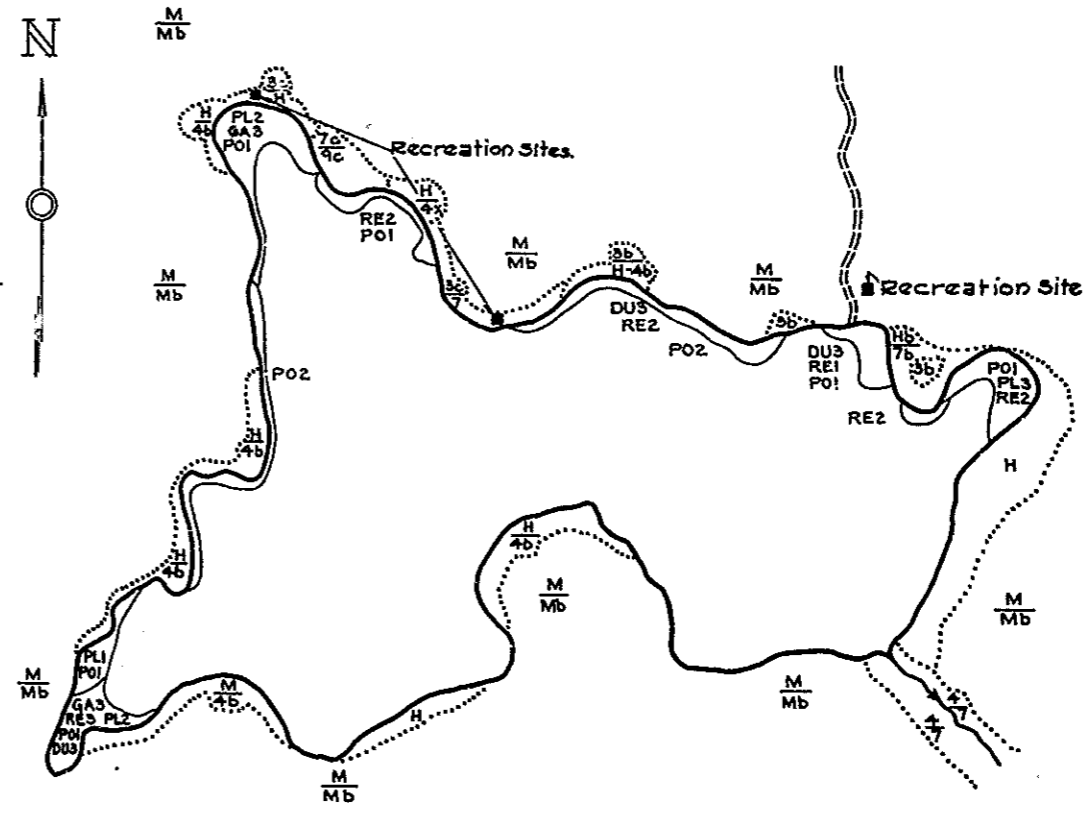

Cover Type and
Aquatic Vegetation Map

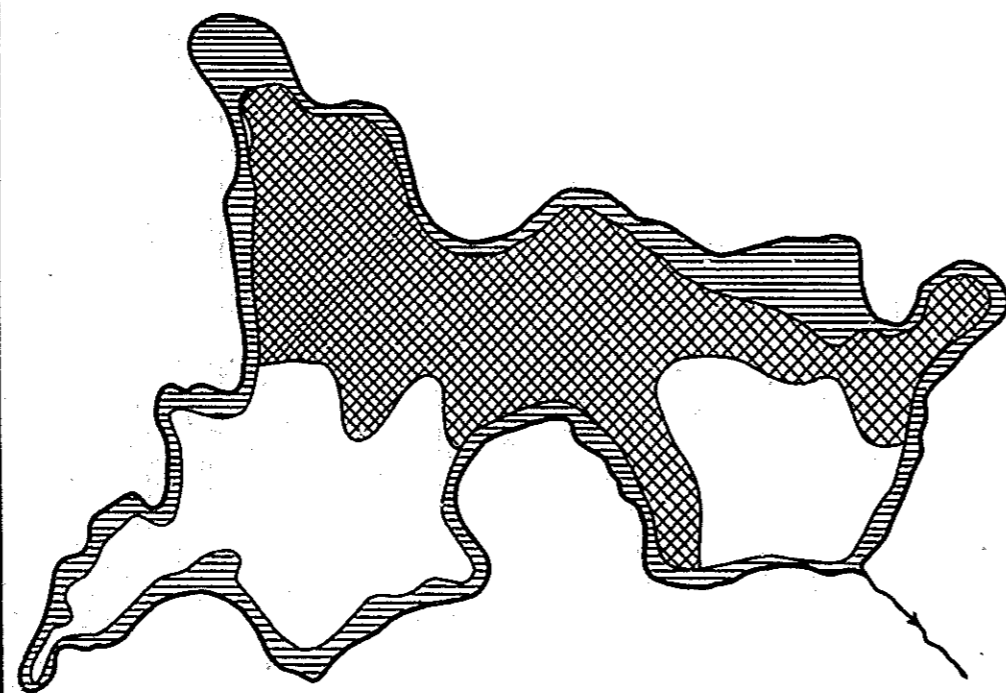

Lake Bottom Soil Type Map

210 HOAD-TYPE FISH SHELTERS IN 8 GROUPS
OF 10 SHELTERS EACH PLUS 130 SHELTERS
(X) SCATTERED ON A SAND-GRAVEL BAR WITH
WATER 4'-5' DEEP. INSTALLED DURING THE FALL
OF 1958 BY THE DEPT. OF CONSERVATION

J-6-5