38-2

Township No. 48 N. Range No. 21 W. Mer. Mich.

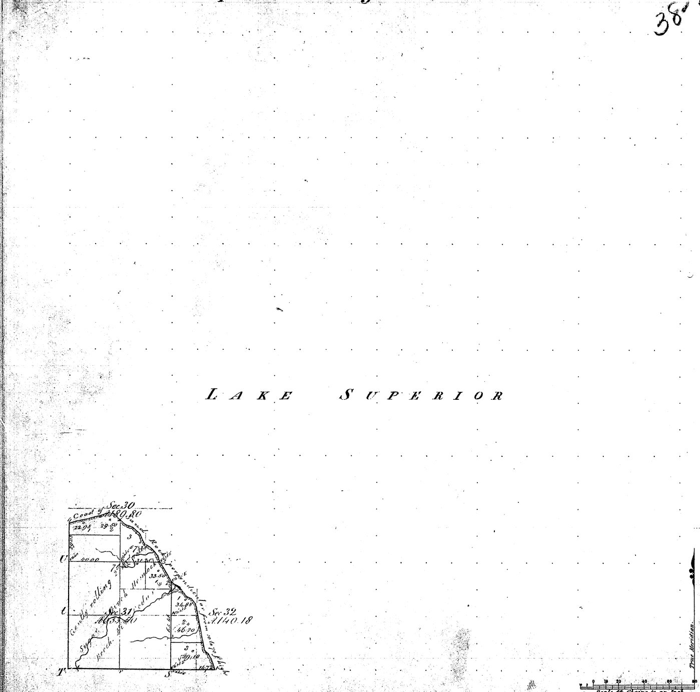

38-2

Meanders of								
Posts	Courses	Chs Lks	Posts	Courses	Chs Lks	Posts	Courses	Chs Lks
			Meander					

Total number of Acres 963.48

Surveys Designated.	By Whom Surveyed.	Date of Contract.	Amount of Surveys M. Chs Lks	When Surveyed.	When Charged in the Surr Genls acct
Township lines.	W. A. Burt	April 1st 1841	1 34 72	3rd Quar 1841	
Subdivisions.	L. B. Searles	April 26 1850	4 00 06	2nd Quar 1850	

The above Map of Township No. 48 North of Range No. 21 West of the Principal Meridian, Michigan is strictly conformable to the field notes of the survey thereof on file in this Office, which have been examined and approved.

Surveyor General's Office.
Detroit June 30 1851

Charles Noble
Surr Genl