Township No. 47 N. Range No. 22 [redacted] Mer. Mich.

381

Meanders of						
North	Courses	Dist. Lks.	South	Courses	Dist. Lks.	East	Courses	Dist. Lks.
				Meanders Brule River				

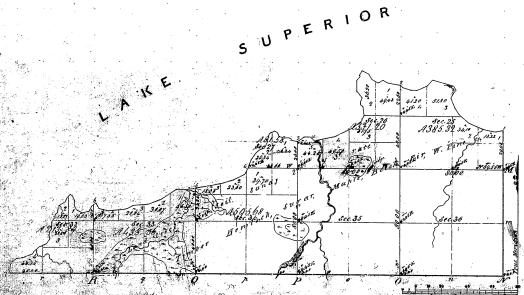

Total Number of Acres 3371.29

Survey Completed	By Whom Surveyed	Date of Contract	Date of Survey: Commenced	Date of Survey: Completed	When Approved	When Received in the Surveyor Gen'l's Office
Township Lines	Wm. M. Ball	April 21 1862	[illegible]	3 Quan 1862		
Subdivision	Wm. M. Ball	[illegible]	[illegible]	[illegible]		

Meanders and Traverse of Township No. 47 N. of Range No. 22 W. of the Principal Meridian in the State of Michigan, as actually surveyed in the year 1862 by the undersigned, in pursuance of Contract dated [illegible] 1862 and in conformity to the Instructions of the Surveyor General of the United States bearing date [illegible] 1862.

[redacted]

Surveyor

381-1