Township No. 49 N. Range No. 14 West Mer. Michigan

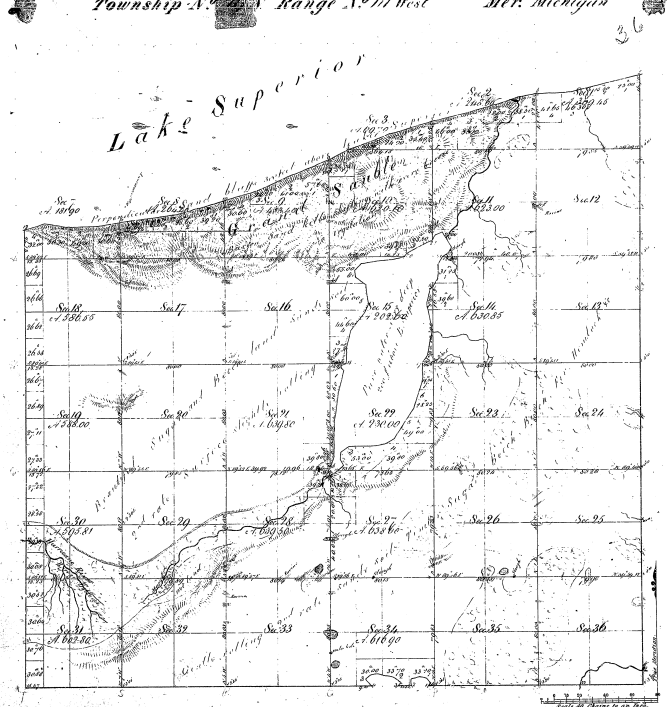

Meanders of

Pts.	Courses	Ch's Lks	Pts.	Courses	Ch's Lks	Pts.	Courses	Ch's Lks

Meanders 12 miles 70 chains 16 links

Total number of Acres 17761.96

Survey Designated.	By Whom Surveyed.	Date of Contract.	Amount of Survey M.	Ch's	Lks	When Surveyed.	When Changed in the Gen'l Land Off.
Township Lines.	Wm. H. Bush	April 1 1851	18.	50.	17	16th June 1851	
Subdivisions.	Geo. E. Hollister	April 9 1851	42.	16.	39	3rd & 4th Oct. 1851	

The above Map of Township No. 49 North of Range No. 14 West of the Principal Meridian Michigan is strictly conformable to the field notes of the survey thereof on file in this Office, which have been examined and approved.

Surveyor General's Office,
Detroit, July 19 1852.

Charles Noble Surv. Genl