


Township N. II North Range N. XVI West Mer. (Mic. Ton)

L. MICHIGAN.

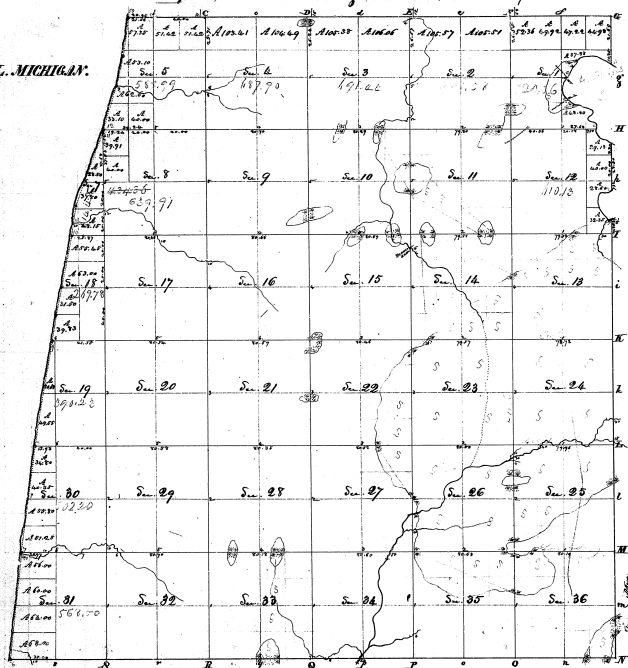

Pat. boundaries of Town	12. Nov. 1830	16. 27. 36	22. 1831	1832
Subdivisions of Section	6. 1831	66. 04. 18	2.	2.


M. F. Williams
Sur. Genl.

