


Township N. III North, Range N. XIII West Mer. (Mch. Ter.)

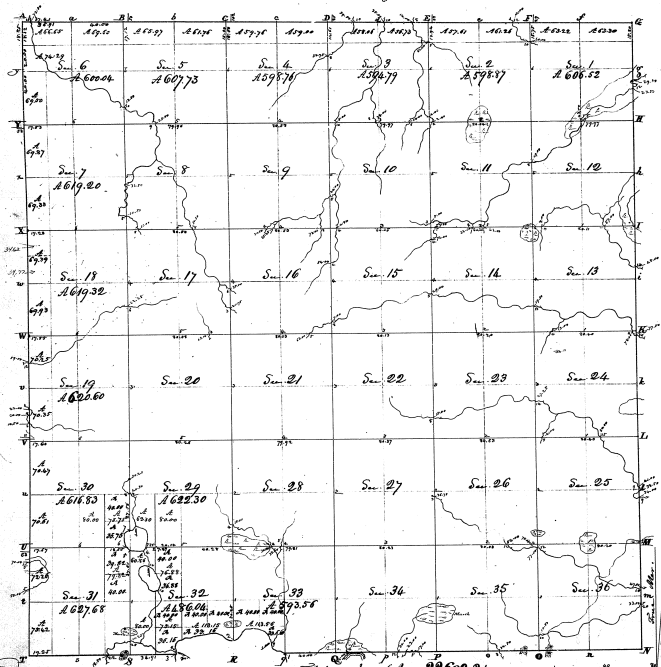

Total number of Acres 22692.24

The above Map, of Township N. III North, of Range N. XIII West of the Meridian, Michigan Territory, is strictly conformable to the field notes of the Survey thereof, on file in this Office, which have been examined and approved. 



157
8-29