Reserve

Township No. 51 N. Range No. 8 E. Mer. Mich.

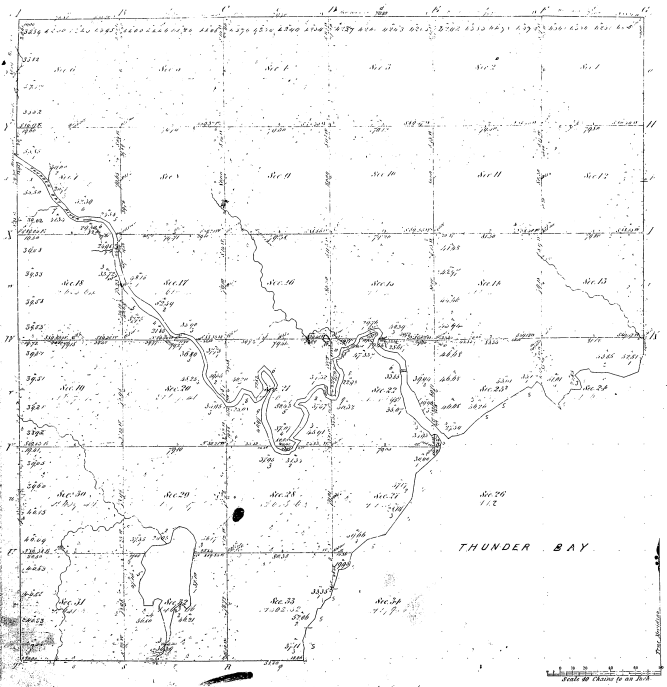

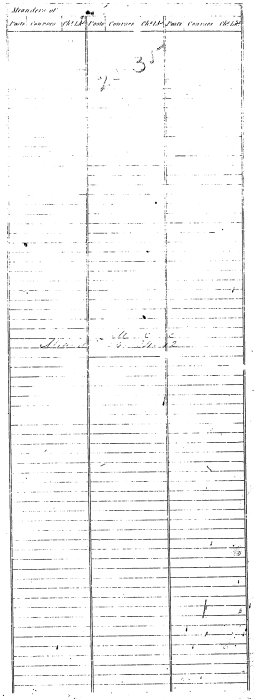

20-35

Total number of Acres 1st 852.56

Surveys Designated.	By Whom Surveyed.	Date of Contract.	Amount of Surveys M.	Cha	Lks	When Surveyed.	When Charged to the Surveyor Gen'l acct.
Township lines &c.	Lemuel Cram	March 7th 1840	2	69	00	3rd Quar. 1840	
Sub-divisions.	B.F. Sabin Hartgrave	Jan. 28th 1840	3	13	00	4th Quar. 1840	
	Samuel Ferguson	Feb. 11th 1845	64	89	00	2d Quar. 1846	
Outer lines	Bradley Cross	May 22d 1845	8	00	00	3d Quar. 1845	

The above Map of Township No. 51 North of Range No. 8 East of the Principal Meridian; as per Field Notes & Original Plat of Survey thereof returned to this Office, is hereby approved and accepted.

Surveyor Generals Office, Detroit, June 26th 1846

Charles C. Comstock Surv. Gen'l