15-7

Re-Survey of

Township No. 29 N. Range No. 7 W. Mer. Mich.

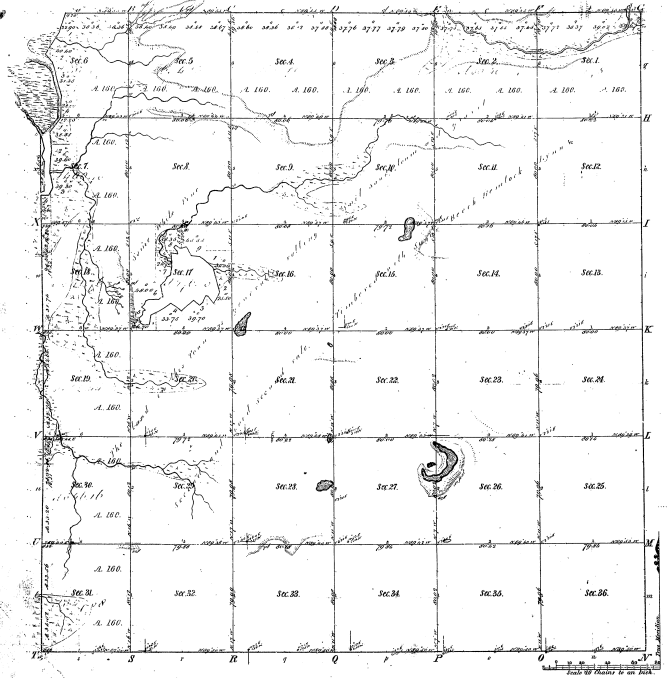

Meanders of								
Posts	Courses	Ch.s Lk.s	Posts	Courses	Ch.s Lk.s	Posts	Courses	Ch.s Lk.s

Note. The blue figures and marks show the position of the old corners and lines

Meanders 5 m. 53 ch. 55 lks.

Total number of Acres. 22315.71

Surveys Designated	By Whom Surveyed	Date of Contract	Amount of Surveys	When Surveyed	When p.d for and ch.d in the Surv.r Gen.l Ofc.
3 Meanders of Township lines	Lucius Lyon Sidley & Hodgson	April 19 1836 Jan. 28 1839	5. 68. 56 6. 00. 00	3rd Quar. 1835 2nd Quar. 1839	3rd Quar. 1836 2nd Quar. 1839
Sub Divisions			62. 32. 21	2nd Quar. 1839	

The above Map of Township No. 29 North of Range No. 7 West of the Principal Meridian Michigan is strictly conformable to the field notes of the survey thereof on file, in this Office, which have been examined and approved.

Surveyor General's Office,
Detroit, Feb. 21 1851

Charles Noble
Surv. Genl.