Mich.

15-3

Township No. 30 N, Range No. 6 West Mer. (Mich.)

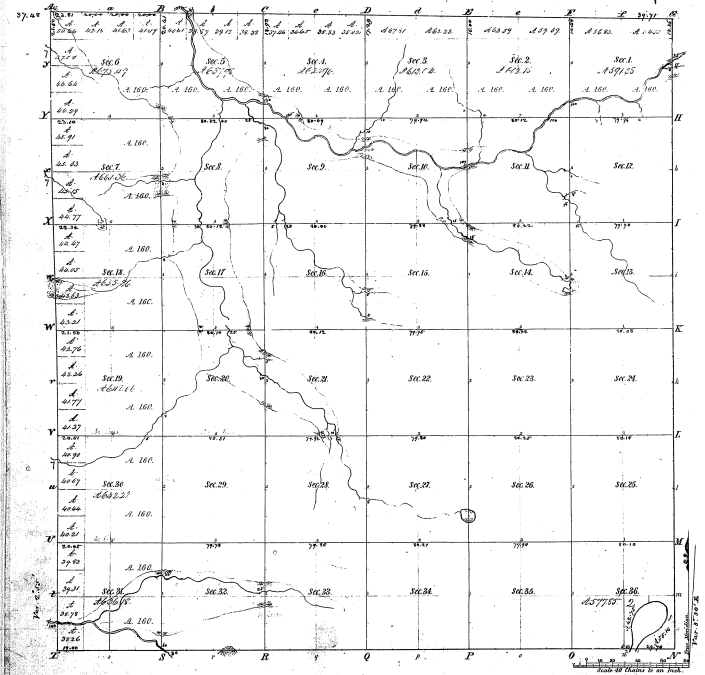

Meanders of part of a Lake in Section 36.

Posts	Courses	Ch. Lk.	Posts	Courses	Ch. Lk.	Posts	Courses	Ch. Lk.
1	N 41 E	12.50						
	N 67 E	15.00						
	N 22½ E	11.00						
	N 26 W	16.00						
	N 84 W	7.50						
	S 69 W	13.50						
	S 24 W	13.50						
	S 5 E	14.00						
2	S 31 W	4.10						

Total number of Acres. 22,982.21

Surveys Designated	By Whom Surveyed	Date of Contract	Amount of Surveys	When Surveyed	When Sur. Gen. Ord. in the Sur. Gen. Ord.
Township	Mulett & Burnett	Feb. 18. 1839	11. 72. 36	2 yr. 1839	4 yr. 1839
Subdivisions	Mulett & Burnett	"	62. 19. 53	3 "	"
Dist. W. bound by Sibley & Hodges		Jan. 26. 1839	12. 05. 31	1 "	3 "

The above Map of Township No. 30 N. of Range No. 6 West of the Principal Meridian, Michigan is strictly conformable to the field notes of the survey thereof on file in this Office, which have been examined and approved.

Surveyor Generals Office,
Cincinnati, May 12. 1840

Spr. Genl.