



Mer. Mich.

34-2

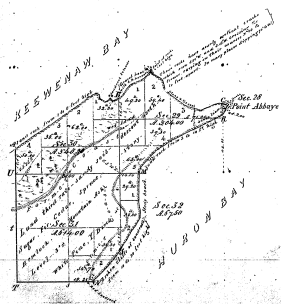

Section	Acres	Survey	When Surveyed	By	Remarks

39-2

36
4

Scale of Chain to an Inch

Total number of Acres 1,327.80


This above map of Township N^o 55 North of Range N^o 50 West of the Principal Meridian is a duly performed and approved survey of the land hereon as filed in this office, which have been examined and approved.
 Surveyor General Office
 Detroit, Mich. 1847

Lewis Lyon, Sur^r Genl