


Township No. 26 N. Range No. 15 West. Mer. (Mich.)

11-14

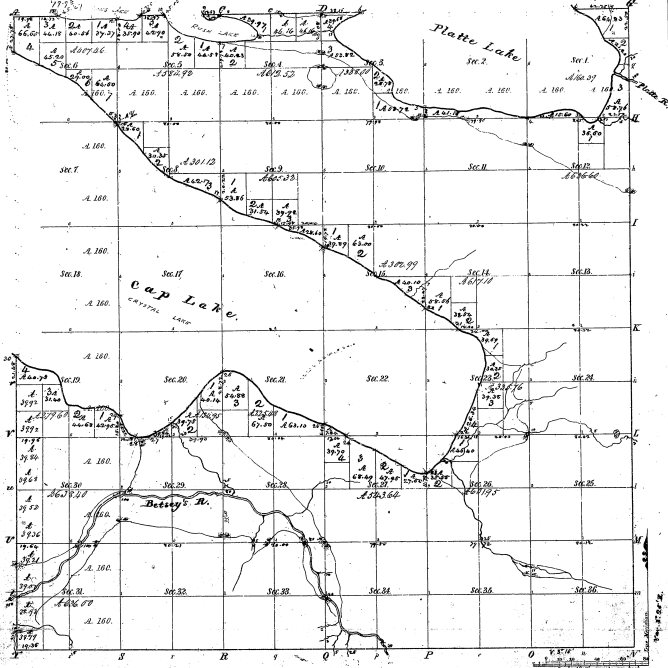


17-14



The above map of Township No. 26 N. of Range No. 15 West of the Meridian, Mich., is hereby approved and approved of the survey thereof by the Commission on the 25<sup>th</sup> of August 1857.

Commissioners of the General Land Office

C. R. ...