Township N. VI South, Range N. VIII West Mer. (Mic. Twp.)

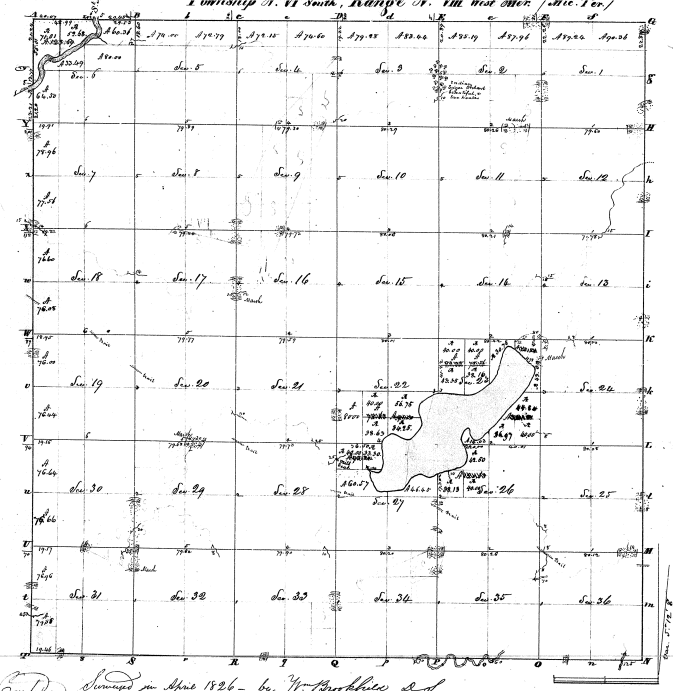

Surveyed in April 1826 — by Wm. Brookfield D.S.

Contract

Sections	Acres	Wts.
NE ¼ 1	40	38
SE "	80	
NE NW "	89	24
SE "	80	
SW "	320	
NE ¼ 2	87	96
SE "	80	
NE NW "	83	19
SE "	80	
SW "	320	
NE ¼ 3	83	44
SE "	80	
NE NW "	79	23
SE "	80	
SW "	320	
NE ¼ 4	76	60
SE "	80	
NE NW "	72	15
SE "	80	
SW "	320	
NE ¼ 5	78	79
SE "	80	
NE NW "	74	
SE "	80	
SW "	320	
NE ¼ 6	80	36
SE "	80	
NW fract. "	123	69
SE fr NW "	33	49
SE "	160	
E ½ W "	80	
W "	64	50
Sec. 7	320	
E ½ NW "	80	
NE "	78	96
E ½ SW "	80	
W "	77	76
Sec. 8	640	
9	640	
10	640	
11	640	
12	640	
13	640	
14	640	
15	640	
17	640	
Sec. 18	320	
E ½ NW "	80	
NE "	78	40
E ½ SW "	80	
W "	76	08
	11335	25

Sections	Acres	Wts.
E ½ 19	320	
E ½ NW "	80	
NE "	76	
E ½ SW "	80	
W "	76	66
Sec. 20	640	
21	640	
N ½ 22	320	
S ½ E "	97	
E ½ SW "	75	63
NE "	80	
SE NE 23	73	84
E ½ NW "	78	16
W "	83	35
E ½ SE "	121	81
" SW "	164	03
Sec. 24	640	
25	640	
N ½ 26	480	
E ½ NW "	320	65
SE NW "	46	65
NE "	73	30
S ½ SW "	60	57
SE "	320	
Sec. 27	640	
29	640	
E ½ 30	320	
E ½ NW "	80	
W "	74	64
E ½ SW "	80	
W "	74	66
E ½ 31	320	
E ½ NE "	80	
W "	74	96
E ½ SW "	80	
W "	79	56
Sec. 32	640	
33	640	
34	640	
35	640	
36	640	
	10777	53
	11335	25
Total	22535	08

Edward Tiffin Surv. Gen.