Township N. 1 south, Range N. VI west (Miami Surv.)

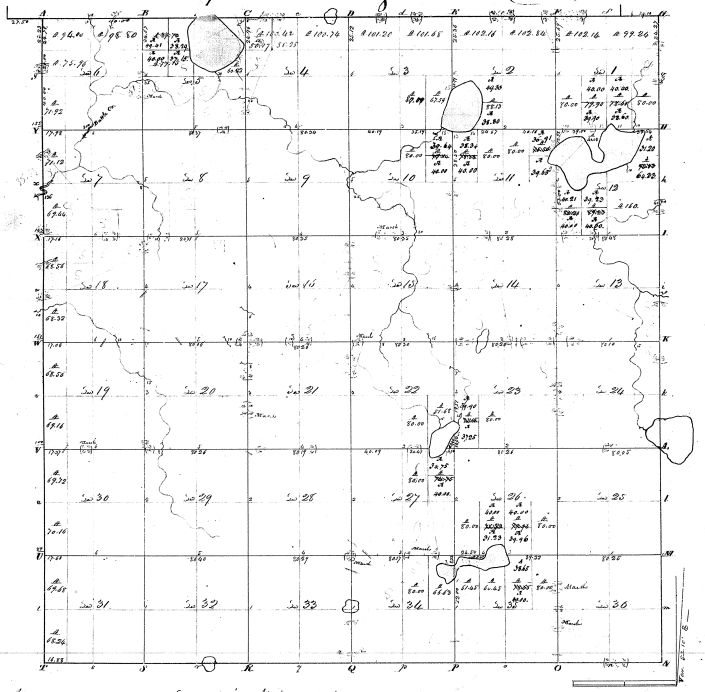

Surveyed in April 1826. by Sylvester Sibley D. S.

Examined

Edward Tiffin Surv. Gen.l

Frl N. E.	1	99	21	Sec.	13	640	
Sec.		80			14	640	
Frl N. W.		102	10		15	640	
Sec.		80			16	640	
Sec. S. E.		80			17	640	
Frl		79	60	Sec.	18	320	
Sec. S. W.		79	90	Sec. N. W.		80	
Mx.		80		Mx.		68	56
Frl N. E.	2	102	80	Sec. S. W.		80	
Sec.		80		Mx.		68	32
Frl N. W.		102	16	Sec.	19	320	
Sec.		80		Sec. N. W.		80	
S. E.		160		Mx.		68	56
Sec.		88	13	Sec. S. W.		80	
Frl N. E.	3	101	60	Mx.		69	16
Sec.		80		Sec.	20	640	
Frl N. W.		101	20		21	640	
Sec.		80		Sec.	22	320	
Sec. S. E.		67	59	S. E.		3	61
Mx.		80		Sec. S. E.		51	68
S. W.		160		Mx.		80	
Frl N. E.	4	102	74	S. W.		102	
Sec.		80		Sec.	23	320	
Frl N. W.		101	42	S. E.		160	
Sec.		80		Sec. S. W.			
Sec.		320		Mx.			
N. E.	5	60	89			24	
Frl N. W.		37	72			23	
Sec.		77	13	Sec.	26	320	
Sec.		320		Sec. S. E.		90	
Frl N. E.	6	98	80	Mx.		79	96
Sec.		80		Sec. S. W.		71	23
Frl N. W.		94		Mx.		80	
Sec.		75	96	Sec. N. E.	27	74	75
S. E.		160		Mx.		80	
Sec. S. W.		80		N. W.		160	
Mx.		79	95	Sec.		320	
Sec.	7	320		Sec.	28	640	
Frl N. W.		80			29	640	
Mx.		71		Sec.	30	320	
Sec. S. W.		80		Sec. N. W.		80	
Mx.		69	46	Mx.		69	72
Sec.	8	640		Sec. S. W.		80	
	9	640		Mx.		69	16
Sec. N. E.	10	79	60	Sec.	31		
Mx.		80		Sec. N. W.		80	
N. W.		160		Mx.		69	68
Sec.		320		Sec. S. W.		80	
Frl N. E.	11	76	56	Mx.		68	24
Mx.		80		Sec.	32	640	
Sec. N. W.		80			33	640	
Mx.		58	34	Sec. N. E.	34	68	63
Sec.		320		Mx.		80	
N. E.	12	75	53	N. W.		160	
N. W.		24	68	Sec.		320	
S. E.		160		Sec. N. E.	35	80	
Sec. S. W.		89	23	Mx.		78	65
Mx.		80	21	Sec. N. W.		80	45
		74	70	Mx.		61	45
			34	N. W.		5	42
				Sec.		320	
				Sec.	36	640	
						1713	14
						1713	56
						3485	70 Total

3-5