3-37

Township No. IV South, Range No. VII West Mer. (Mic. Ter.)

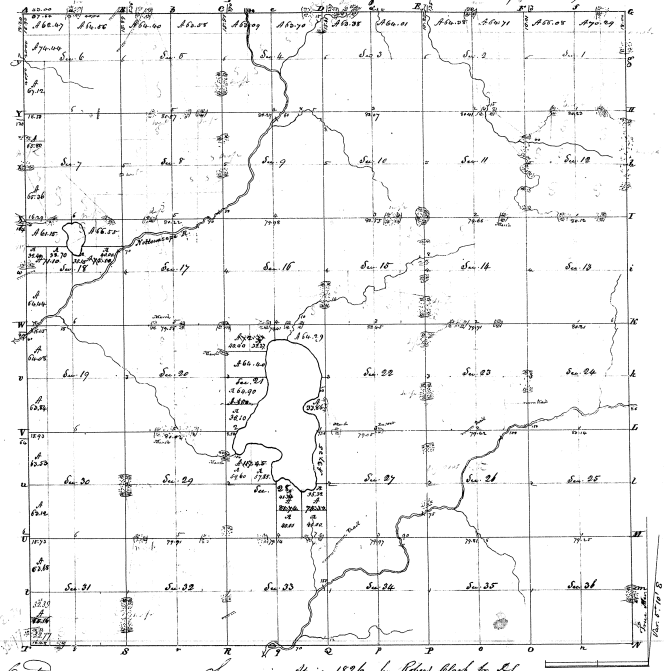

Contents

Section	Acres	Hdts	Section	Acres	Hdts
NL NE 1	70	29	EL 19	320	
SL "	80		EL NW "	80	
NL NW "	66	08	WL "	64	08
SL "	80		EL SW "	80	
S½ "	320		WL "	63	84
NL NE 2	64	71	Sec. 20	640	
SL "	80		NE 21	64	29
NL NW "	64	38	NL NW "	72	37
SL "	80		SL "	64	40
S½ "	320		SE "	33	86
NL NE 3	64	01	SW "	100	
SL "	80		Sec. 22	640	
NL NW "	63	38	23	640	
SL "	80		24	640	
S½ "	320		25	640	
NL NE 4	63	70	26	640	
SL "	80		27	640	
NL NW "	63	09	NE 28	37	35
SL "	80		NW "	117	45
S½ "	320		EL SE "	75	32
NL NE 5	63	58	WL "	81	74
SL "	80		SW "	160	
NL NW "	64	40	Sec. 29	640	
SL "	80		EL NW 30	80	
S½ "	320		WL "	63	50
NL NE 6	64	56	EL SW "	80	
SL "	80		WL "	63	12
NL NW "	62	47	E½ "	320	
SL "	74	44	EL NW 31	80	
SE "	160		WL "	63	68
EL SW "	80		EL SW "	80	
WL "	67	12	WL "	65	16
E½ 7	320		E½ "	320	
EL NW "	80		Sec. 32	640	
WL "	65	50	33	640	
EL SW "	80		34	640	
WL "	65	36	35	640	
Sec. 8	640		36	640	
9	640			10,850	19
10	640			11,225	71
11	640		Total	22,075	90
12	640				
13	640				
14	640				
15	640				
16	640				
17	640				
NL NE 18	66	55			
SL "	75	10			
NL NW "	61	15			
SL "	71	10			
SE "	160				
EL SW "	80				
WL "	64	44			
	11,225	71			

Surveyed in April 1826 by Robert Clark Jr. D.S.

Comp.

Edward Tillson Surv.r Gen.