Township N. V south, Range N. IV West Mer. (Mic. Ten)

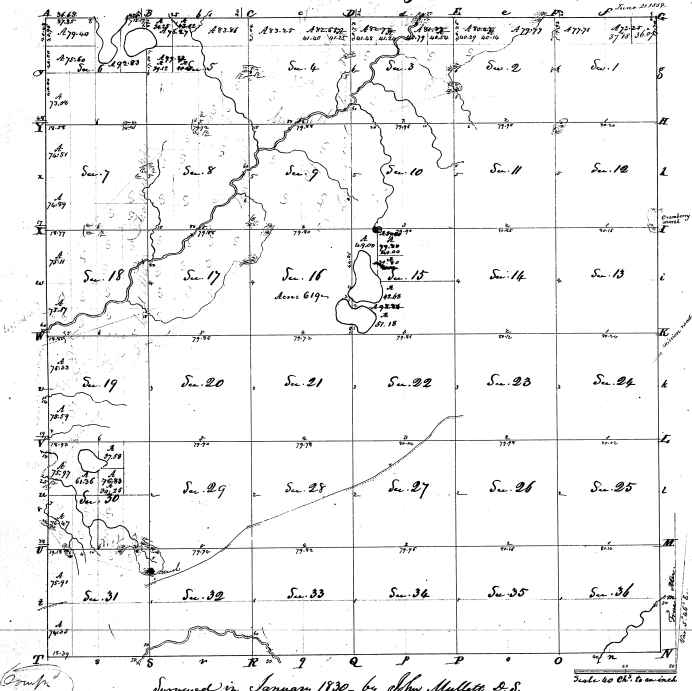

Surveyed in January 1830 by John Mullett, D.S.

Scale 40 Chs. to an inch

277

Section No. Sections	Acres	Hds.	Contents Sections	Acres	Hds.
NL NE 1	93	23	[illegible]	320	
SL " "	80		[illegible]		
NL NW "	77	71	EL NW "	80	
SL " "	80		WL " "	75	33
" SW "	320		[illegible]		
NL NE 2	77	77	EL SW "	80	
SL " "	80		WL " "	75	57
NL NW "	80	63	" Sec. 20	640	
SL " "	80		21	640	
" SW "	320		22	640	
NL NE 3	92	33	23	640	
SL " "	80		24	640	
NL NW "	92	72	25	640	
SL " "	80		26	640	
" SW "	320		27	640	
NL NE 4	93	65	28	640	
SL " "	80		29	640	
NL NW "	93	25	EL NE 30	80	
SL " "	80		WL " "	74	93
" SW "	320		EL NW "	61	36
NL NE 5	93	35	WL " "	75	57
SL " "	80		" SE "	160	
NL NW "	74	27	EL SW "	80	
SL " "	79	72	WL " "	54	47
" SW "	320		" Sec. 31	320	
" NE 6	92	83	EL NW "	80	
NL NW "	79	60	WL " "	75	91
SL " "	75	60	EL SW "	80	
" SE "	160		WL " "	74	35
EL SW "	80		" Sec. 32	640	
NL " "	73	08	33	640	
EL " 7	320		34	640	
EL NW "	80		35	640	
NL "	74	51	36	640	
EL SW "	80			11648	81
WL "	76	89		11382	63
Sec. 8	640		Total	23230	44
9	640				
10	640				
11	640				
12	640				
13	640				
14	640				
EL 15	320				
EL NW "	79	80			
WL "	49	00			
" SW "	93	85			
Sec. 16	619	00			
17	640				
EL 18	320				
EL NW "	80				
WL " "	75	11			
EL SW "	80				
WL "	76	77			
	11382	63			

2-11