Resurvey

Township No. 32 N. Range No. 7 W. Mer. Mich.

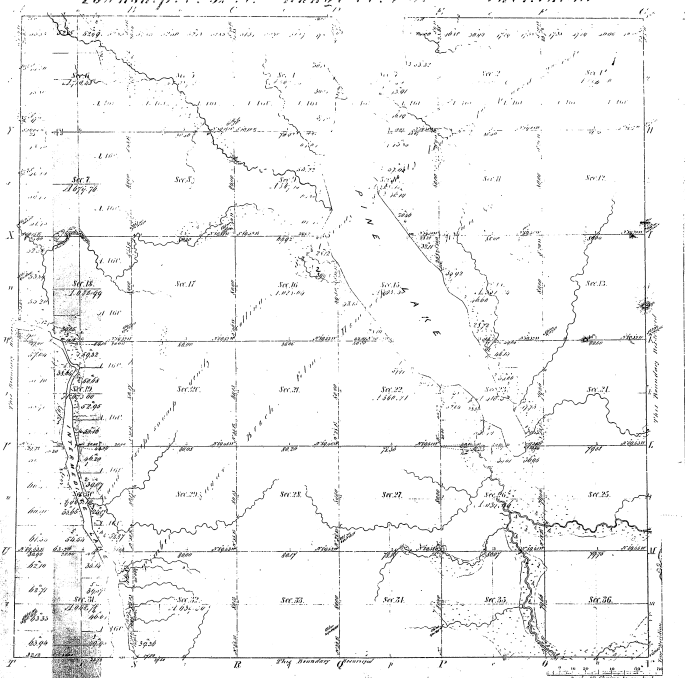

Total number of Acres 21749.70

Surveyed	By Whom Surveyed	Date of Contract	Amount of Surveys	When Surveyed	When Ch. for and ch. in the Inv. Gen. Ofc.
Town	Ed. D. Atwater		21 Ch. 15 Lks. / 12 Ch. 15 Lks.	4th Quar. 1836	
Subdivision	Ed. D. Atwater	April 10th 1836	72 Ch. 62 Lks.	4th Quar. 1836	

The above Map of Township No. 32 N. Range No. 7 West of the Principal Meridian of Michigan is hereby conformable to the field-notes of the survey thereof in the Office which has been examined and approved.

Surveyor General's Office
Detroit May 10th 1837

C. L. Emerson
Sur. Genl.

18-27