Resurvey

Township No. 35 N. Range No. 1 W. Mer. Mich.

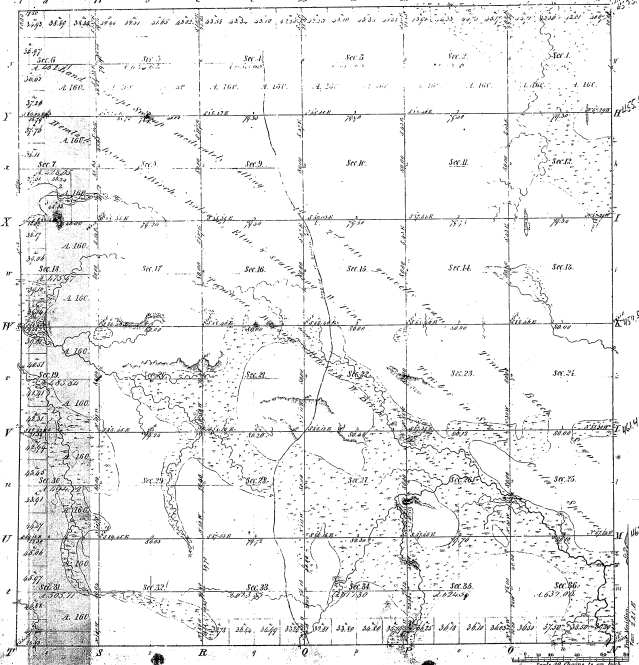

Total number of Acres 22,057.53

Survey Designated	To Whom Surveyed	Date of Contract	Amount of Surveys	When Surveyed	Where Cor. and 1/4 S on the Tow'ship line are
Township	Jos. Mullett	1st of 16th 1840	M. 187 Ch. 50 L.	9th Quar. 1840	
Subdivisions	Nat. H. Cannon	October 6th 1855	89 M. 00	2nd Quar. 1855	
Meanders	John Hodgson	Jan. 16th 1850	6 M. 00	2nd Quar. 1850	

The above Map of Township No. 35 N. of Range No. 1 W. Principal Meridian of Michigan is strictly conformable to the field notes of the survey thereof, returned to this Office, which have been examined and approved.

Surveyor General's Office, Detroit, Oct. 31st 1856.

L. Lesley Jr. Surveyor General.
Spec. Draft.

Cert. Copy