33-12

Township No. 44 N. Range No. 3 E. **Mer. Mich.**

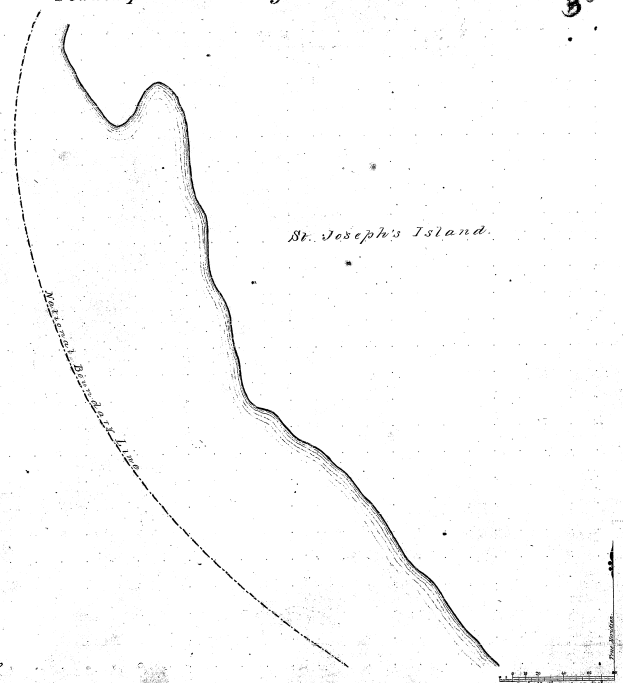

Meanders of								
Posts	Courses	Ch.s Lk.s	Posts	Courses	Ch.s Lk.s	Posts	Courses	Ch.s Lk.s

Total number of Acres 3.40

Surveys Designated.	By Whom Surveyed.	Date of Contract.	Amount of Surveys M. Ch.s Lk.s	When Surveyed.	When Charged in the Surv.r Gen.l's acc.t
Township lines.	Thos. Mullett	April 2. 1845	19. 50	4.d yr 1845	
Subdivisions.					

The above Map of Township No. 44 N. North of Range No. 3 East of the Principal Meridian. Michigan is strictly conformable to the field notes of the survey thereof on file in this Office, which have been examined and approved.

Surveyor General's Office.
Detroit Jany 31 1846

Lucius Lyon, Sur.r Gen.l

ORIGINAL

TOWNSHIP 44 NORTH, RANGE 3 EAST, OF THE MICHIGAN MERIDIAN, MICHIGAN.

SURVEY OF ISLANDS

33-12

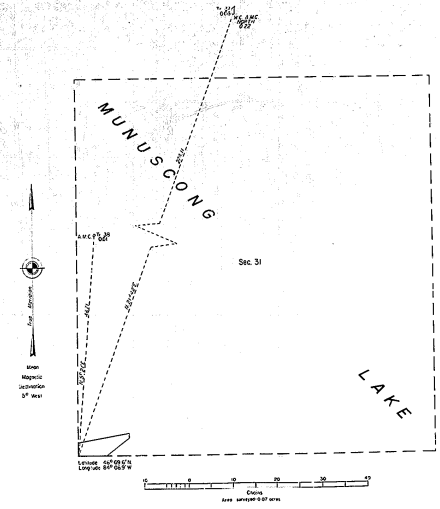

A history of surveys is contained in the field notes.

This plat represents the survey of two islands in Munuscong Lake, T. 44 N., R. 3 E., Michigan Meridian, Michigan.

Except as indicated hereon, the area is as shown on the plat approved January 31, 1846.

Survey executed by Gary L. Kratz, Cadastral Surveyor, beginning July 26, 1977, and completed May 23, 1978, pursuant to Special Instructions dated June 3, 1977, for Group No. 78, Michigan.

UNITED STATES DEPARTMENT OF THE INTERIOR
BUREAU OF LAND MANAGEMENT
Denver, Colorado December 19, 1981

This plat is strictly conformable to the approved field notes, and the survey, having been correctly executed in accordance with the requirements of law and the regulations of this Bureau, is hereby accepted.

For the Director

Acting Chief, Cadastral Survey
Examination and Approval Staff