Township No. 47 N. Range No. 7 W. Mer. Mich.

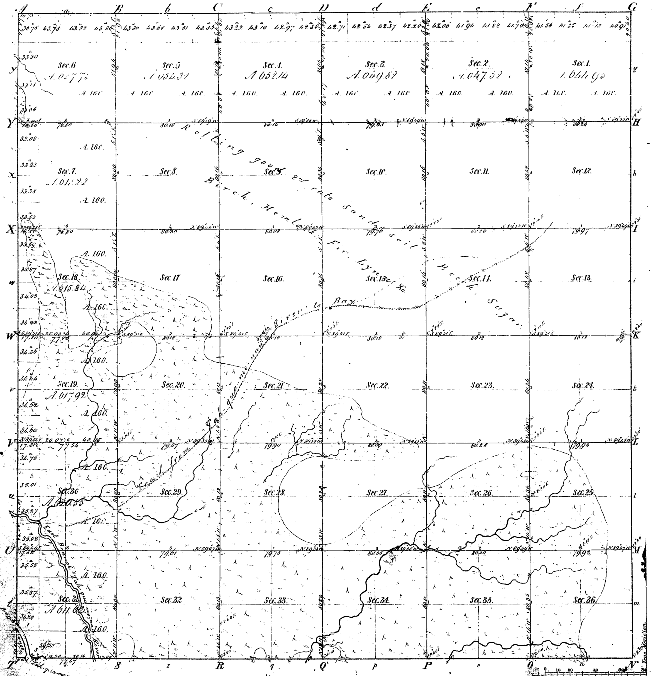

Meanders of								
Posts	Courses	Chs. Lks.	Posts	Courses	Chs. Lks.	Posts	Courses	Chs. Lks.

35-16

Total number of Acres 22.955.65

Surveys Designated	By Whom Surveyed	Date of Contract	Amount of Surveys (M. Chs. Lks.)	When Surveyed	When pd. for and chd. in the Sur. Genl's acct.
Township lines	Wm. A. Burt	Jan 15 1840	11. 77 87	2nd Quar 1840	
Subdivisions	Wells Burt	June 29 1849	60. 55. 30	2nd Quar 1850	

The above Map of Township No. 47 North of Range No. 7 West of the Principal Meridian Michigan is strictly conformable to the field notes of the survey thereof on file in this Office, which have been examined and approved.

Surveyor General's Office,
Detroit June 5th 1851

Charles Noble
Sur. Genl.