Township N.º 50 N. Range N.º 6 W. Mer. Mich.

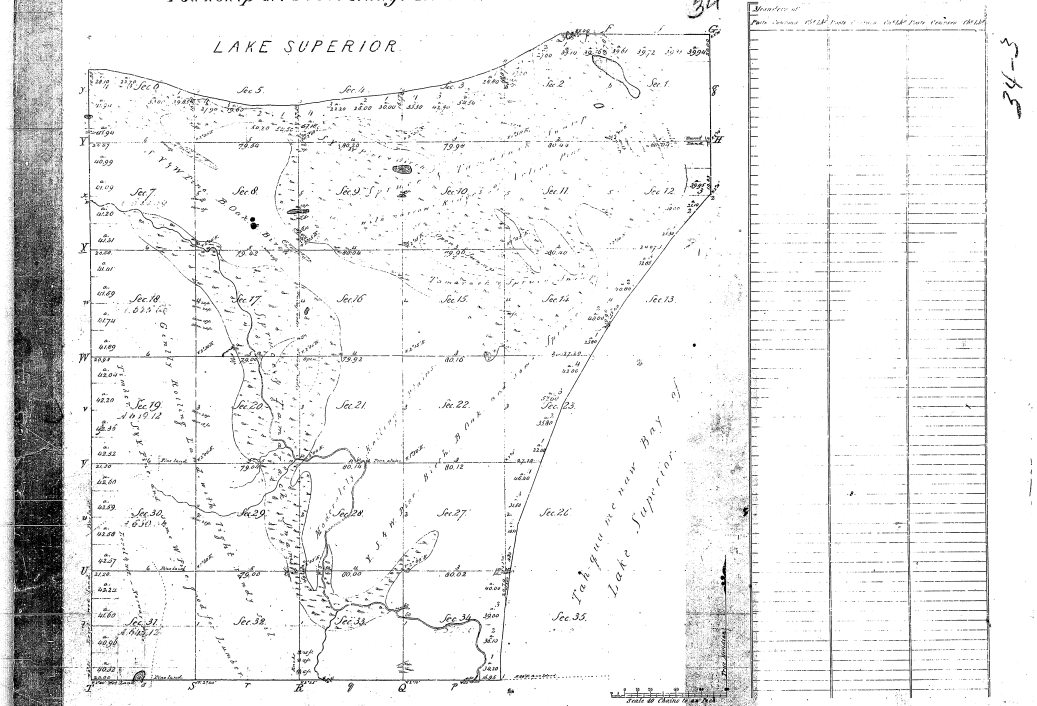

Total Number of Acres 17723.02.

Surveys Designated.	By Whom Surveyed.	Date of Contract.	Amount of Surveying. M.	Ch.	Lks.	When Surveyed.	When Charged to the Surveyor's acct.
Township Lines.	Wm. A. Burt.	June 15 1840	5.	36.	78.	2d Qr. 1840.	
Subdivisions.	Wm. Burt.	June 29 1840	53.	00.	00	3d Qr. 1840	

The above Map of Township 50 N. of Range 6 W. of the Principal Meridian, Michigan, is protracted conformable to the field notes of the survey thereof on file in this Office, and is hereby examined and approved.

Surveyor General's Office
Detroit Mar. 4th 1850

Surv. Genl.