Resurvey

Township No. 18 N. Range No. 3 W. Mer. Mich.

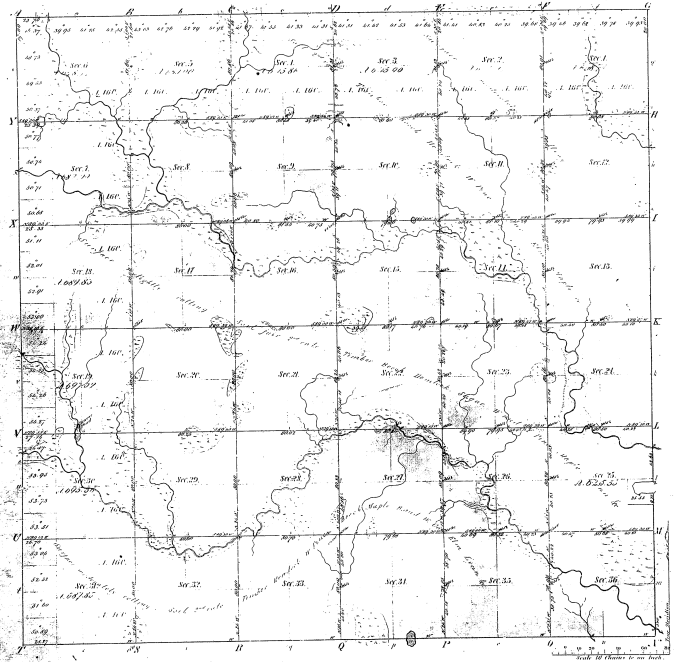

Meanders of

Posts Courses	Chs. Lks.	Posts Courses	Chs. Lks.	Posts Courses	Chs. Lks.

Alteration 37 Chains 76 Lks.

Note Lots dotted Yellow sold prior to the resurvey

13-11

Total number of Acres 25,340.00

Surveys Designated	By Whom Surveyed	Date of Contract	Amount of Surveys	When Surveyed	Whom Surveyed
Township lines	Henry Nicholson	July 30th 1838	31 Chs. 14 Lks. 17 65 27	3rd Quar. 1838	
Subdivisions	Geo. H. Cannon	September 17th 1856	61 85 98	4th Quar. 1856	

The above Map of Township No. 18 North of Range No. 3 West of the Principal Meridian Michigan is strictly conformable to the field notes of the Surveys thereof on file in this Office which have been examined and approved.

Surveyor General's Office
Detroit February 19th 1857

Saunders Chapman
Cons. Copy